

Claiborne
K 2001
2-68

MISSISSIPPI
BOARD OF WATER COMMISSIONERS
416 North State Street
Jackson, Mississippi 39201

WATER WELL DRILLERS LOG

2-20 1968 FB Fore Claiborne
date well completed firm name county well located

LANDOWNER: <u>Alphonse Wells</u>	description of formations encountered	from	to
<u>Lorman, Miss</u> (mailing address)			
	<u>Brown Sh, cl</u>	<u>0</u>	<u>105</u>
	<u>Sd + gravel</u>	<u>105</u>	<u>108</u>
WELL LOCATION: <u>24</u> sec <u>T 11</u> N <u>R 1 E</u> <u>15</u> miles <u>SW</u> of <u>PT Gibson</u> (distance) (direction) (nearest town)	<u>Sand</u>	<u>108</u>	<u>165</u>

WELL PURPOSE: Home
(home, irrigation, municipal, industrial)

WELL COMPLETION DATA:

(1) diameter (inches) 4 1/4

(2) total depth (feet) 165

(3) static water level (feet) 130 below top of ground.

(4) casing Galv 160
(material) (depth)

(size) If telescope see back.

(5) screen 5 160
(length) (depth to top)

.08 Brass
(size) (material)


(6) pump 3/4 4
(HP) (yield gpm)

Elec
(type power)

(7) electric log No
(yes or no)

None
(organization running log)

BW-Value
(8) how well bottom plugged

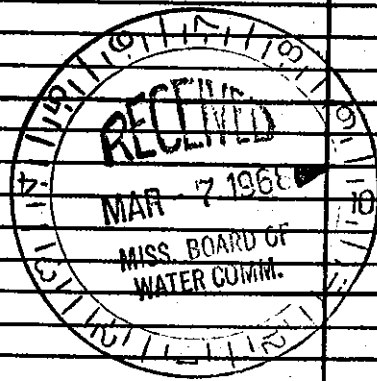

DRILLERS REMARKS: