

Claiborne
 R 2002
 2-68

MISSISSIPPI
 BOARD OF WATER COMMISSIONERS
 416 North State Street
 Jackson, Mississippi 39201

WATER WELL DRILLERS LOG

2-25 1968 WFB Fore Drl Co Claiborne
 date well completed firm name county well located

LANDOWNER: James L. Scott

description of formations encountered from to

Lorman, Miss
 (mailing address)

Brown sd, @ 0 50

WELL LOCATION:

sec 34 T11 N R1E
 15 miles SW of Gibson
 (distance) (direction) (nearest town)

Soft Brown @ 50 80

Brown & White @ 80 110

Brown sd & gravel 110 120

WELL PURPOSE: Home
 (home, irrigation, municipal, industrial)

Sand 120 165

WELL COMPLETION DATA:


- (1) diameter (inches) 4 1/4
- (2) total depth (feet) 165
- (3) static water level (feet) 130' below top of ground.
- (4) casing GALV 160
 (material) (depth)

- (5) screen 5 160
 (length) (depth to top)

- (6) pump 1/2 4
 (HP) (yield gpm)

- (7) electric log ELEC
 (type power)
- (7) electric log NO
 (yes or no)

- (8) None
 (organization running log)
- (8) B.W. Value
 (how well bottom plugged)

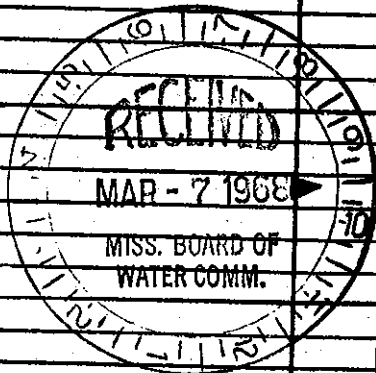

DRILLERS REMARKS: