

Claiborne
L14
6-66

MISSISSIPPI BOARD OF WATER COMMISSIONERS

ELOG # 58
CODED

WATER WELL DRILLERS LOG

Date: June, 1966, Driller: Carlson Well Supply County Claiborne
 (Name)

(1) Owner of Land: <u>Mosswood Country Club, Port Gibson, Miss.</u>	Description & Color of Materials Sand, Clay, Red Clay, Shell, etc.	Thick-ness Feet	Depth Feet
Club, Port Gibson, Miss.	Hard Red Clay	20	20
Approx. 4 Miles South of Port <u>11 2</u>	Hard White Clay	29	49
(2) Location: <u>50. line irr</u> 1/4, 1/4, Sec. <u>44</u> T <u>11</u> R <u>5E</u>	Hard Blue Clay with		
Gibson on Highway 61.	Streaks Sand Rock	45	94
<u>3</u> miles <u>S</u> of <u>Port Gibson</u>	Medium Gray Sand	10	104
(distance) (direction) (Nearest Town)	Medium Gray Sand	54	158
(3) Topography: _____	Hard Blue Clay	3	161
(Hilly) (Flat) (Level)	Coarse Light Gray W.B.		
(4) Purpose of Well: _____	Sand	93	254
(Domestic Irrigation, Municipal, Industrial, Other)	Hard Blue Shale	11	265'


Information upon completion of well:

- (1) Diameter 8 inches.
- (2) Total Depth 226'-3" feet.
- (3) Water Level 120' feet below top of ground.
- (4) Cased to 166'-2", Size 8"
- (5) Screen: Size 6", Length 46'-10"
- (6) Were any formations sealed against pollution?
 yes, no.

Electric Log run by
 Miss. State Geological
 Survey.

If YES depth of formation Casing cemented its entire length.
 Why Standard Procedure

Drillers Remarks:

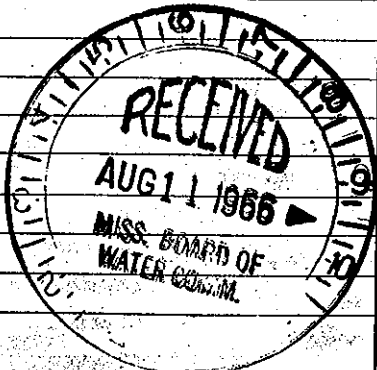

Well No.

(Use Back Side)

Retain this copy for your office files.