

CLAIBORNE MISSISSIPPI BOARD OF WATER COMMISSIONERS

L: 35

WATER WELL DRILLERS LOG

CODED

4-24-62

Date: 4/24, 1962, Driller: Johnnie Beasley County Claiborne
 463 488 (Name)

	Description & Color of Materials Sand, Clay, Red Clay, Shell, etc.	Thick- ness Feet	Depth Feet
(1) Owner of Land: Dalton Davis. (Name)	Brown silt.	16-	16
Port Gibson, Miss. (Address)	Chalk & clay.	34-	50
Go down Hwy. 61 South of Port Gibson to Russum turn East for (2) Location: 1/4, Sec. 20 1025 about 4 miles.	Blue clay & limestone.	70-	120
10 miles Southeast of Port Gib. (distance) (direction) (Nearest Town)	Blue clay.	78-	198
(3) Topography: x (Hilly) (Flat) (Level)	Fine sand.	38-	201
(4) Purpose of Well: Domestic (Domestic Irrigation Municipal, Industrial, Other)	Blue clay.	4-	205
	Soft clay & silt.	10-	215
	Fine sand.	10-	225
	Medium sand. (Screen set)	20-	245

Information upon completion of well:


- (1) Diameter 2 inches.
- (2) Total Depth 245 feet.
- (3) Water level 132' feet below top of ground.
- (4) Cased to 235', Size 2"
- (5) Screen: Size 2", Length 10'
- (6) Were any formations sealed against pollution?
 yes, no.

If YES depth of formation _____

Why _____

Drillers Remarks: Good well.

CODED

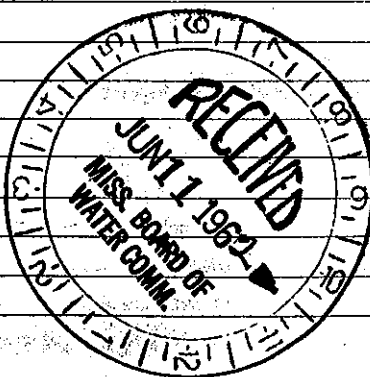

(Use Back Side)

Well No.

Mail this copy to Board of Water Commissioners 429 Miss. St. Jackson, Miss