

CLAIBORNE
 Box L 36
 10-2-62

WATER WELL DRILLERS LOG

CODED EJ

Date: 10/2 & 3, 1962, Driller: Johnnie Beasley County Claiborn

(Name)

1511601

	Description & Color of Materials Sand, Clay, Red Clay, Shell, etc.	Thick- ness Feet	Depth Feet
(1) Owner of Land: <u>Robert Segrest.</u> (Name)	Brown clay.	20	20
<u>Fort Gibson, Miss.</u> (Address)	Chalk.	18	38
(2) Location: <u>45</u> <u>53</u> <u>T11 R26</u>	Blue clay.	32	70
<u>1/4</u> , <u>1/4</u> , Sec. <u>53</u> T. <u>11</u> R. <u>26</u>	Brown clay.	12	82
_____ miles _____ of _____ (distance) (direction) (Nearest Town)	Silt sand & shale.	24	106
(3) Topography: <u>X</u> (Hilly) (Flat) (Level)	Fine sand.	9	115
(4) Purpose of Well: <u>Domestic.</u> (Domestic Irrigation Municipal, Industrial, Other)	Shale.	2	117
	Fine sand.	6	123
	Sand. (Screen setting.)	23	146
	Shale.	14	160

Information upon completion of well:

- (1) Diameter 2" inches.
- (2) Total Depth 146 feet.
- (3) Water Level 100 feet below top of ground.
- (4) Cased to 136', Size 2"
- (5) Screen: Size 2", Length 10'
- (6) Were any formations sealed against pollution?
no.

If YES depth of formation _____


Why _____

Drillers Remarks: Good well.

CODED

FOREST DRILLING SERVICE

P. O. Box 5717
 PEARL BRANCH
 JACKSON 8, MISS.

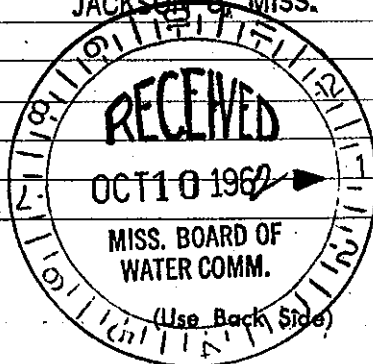

Well No.

Retain this copy for your office files.