

**MISSISSIPPI DEPARTMENT OF NATURAL RESOURCES**

Bureau of Land and Water Resources

**CODED**

P.O. Box 10631

Jackson, Mississippi 39209

**WATER WELL DRILLERS LOG**

COUNTY WELL LOCATED  
**Claiborne**

WELL NUMBER  
**L 78**

DATE WELL COMPLETED  
**7-5-88**

PERMIT NUMBER

NAME OF CONTRACTOR  
**RAINBOW DRILLING, INC.**

**Rt 5 Box 98**

**Natchez MS 39120**

NAME & MAILING ADDRESS OF LANDOWNER  
**Simon M. Losavio**

**P.O. Box 789**

**Port Gibson MS 39150**

WELL LOCATION: SEC **9** TOWNSHIP **11 S** RANGE **2 E**

DISTANCE **2** Miles DIRECTION **W** of NEAREST TOWN **Port Gibson**

OTHER LANDMARK

WELL PURPOSE: Home, Irrigation, Municipal, Industrial, Fish Pond, etc.  
**Home**

**PUMP DATA**

PUMP TYPE (Circle One):  
 Submersible  Turbine  Jet  Flowing Well,  
Other (Describe) \_\_\_\_\_

POWER TYPE (Circle One):  
 Electric  Tractor  Diesel  Gasoline  Butane,  
Other (Describe) \_\_\_\_\_

Pump Capacity (GPM)	No. of Stages	Setting Depth
<b>10</b>	<b>15</b>	<b>160</b> FT.

PUMP TEST **3/4**

Well yielded **10** GPM with  
a drawdown of \_\_\_\_\_ ft.  
after \_\_\_\_\_ hours of pumping

**WELL DATA**

Well Depth <b>165'</b>	Casing Diameter (In.) <b>4"</b>	Casing Length (Ft.) <b>155'</b>
Type of Casing <b>Sch 40 PVC</b>	Hole Depth <b>165'</b>	Depth to Static Water Level <b>90'</b>

TYPE OF COMPLETION: (Circle One or More):  
 Gravel Packed  Underreamed  Telescoped,  
 Natural Development  Open Hole  Other  
(Describe) \_\_\_\_\_

Top of Lap Pipe or Reduction in Casing  
FEET  IF TELESCOPED OR MORE THAN ONE SCREEN: USE BACK PAGE

**LOG DATA**

TYPE OF LOG RUN (Circle One):  
 Electric  Gamma Ray  Density  Sonic  Neutron,  
Other (Describe) \_\_\_\_\_  No Log Run

Name of Organization Running Log

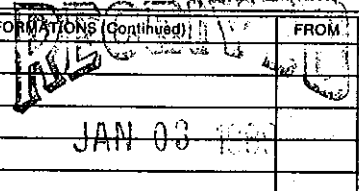
**SCREEN DATA**

Diameter - Inches <b>4"</b>	Length - Feet <b>10'</b>	Slot Size - Inches <b>.010</b>
Screen Type <b>Sch 40 Slotted PVC</b>	Depth to Bottom - Feet <b>165'</b>	

**GEOLOGIC DATA (Office Use Only)**

Surface Elev.	Geologic Unit	Unit Thickness	Depth to Top
Subs. SWL	Date	Analysis	Aquifer Test

Driller's Remarks

DESCRIPTION OF FORMATIONS ENCOUNTERED	FROM	TO	FORMATIONS (Continued)	FROM	TO
Top Soil	0	30			
Chalk	30	84			
Sand	84	100			
Chalk	100	120			
Sand	120	165			

Department of Natural Resources  
Bureau of Land & Water Resources

IF MORE SPACE IS NEEDED, USE BACK