

CLAIBORNE  
~~L 7013~~  
 L91

MISSISSIPPI DEPARTMENT OF NATURAL RESOURCES  
 Bureau of Land and Water Resources  
 Southport Mall  
 P.O. Box 10631  
 Jackson, Mississippi 39209  
**WATER WELL DRILLERS LOG**

4/28 19 86 Rayborn Drlg Co. Claiborne  
 date well completed firm name county well located

LANDOWNER: Eddie Duffin  
Rt 2 Box 156  
Port Gibson Ms 39120  
 (mailing address)


description of formations encountered	from	to
Top Soil	0	15
sand	15	60

WELL LOCATION:  
 sec. 60 T. 11 N. R. 2 E  
S W  
6 miles NW of Russum  
 (distance) (direction) (nearest town)

Shale	60	126
sand	126	157

WELL PURPOSE: home  
 (home, irrigation, municipal, industrial)

- WELL COMPLETION DATA:
- diameter (inches) 4"
  - total depth (feet) 157'
  - static water level (feet) 120' <sup>(below)</sup> above top of ground.
  - casing PVC Sch 40, 147'  
 (material) (depth)  
4" if telescope see back.  
 (size)
  - screen 10', 147'  
 (length) (depth to top)  
4", PVC Sch 40 Slotted  
 (size) (material)
  - pump 3/4 10  
 (HP) (yield gpm)  
electric  
 (type power)
  - electric log no  
 (yes or no)  
 (organization running log)
  - how well bottom plugged WOOD

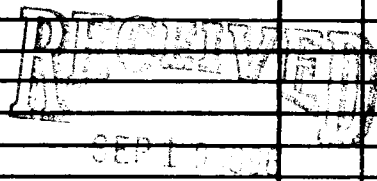


Department of Natural Resources  
 Bureau of Land & Water Resources

DRILLERS REMARKS:

If well telescopes please sketch and show depths.

GROUND LEVEL

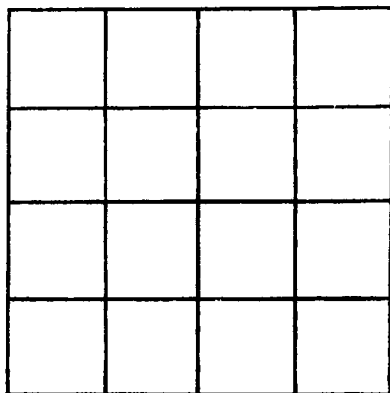

SECTION \_\_\_\_\_

Please indicate well location X.

ADDITIONAL INFORMATION

If more than one screen, show locations of each on sketch.