


CLAIBORNE MISSISSIPPI BOARD OF WATER COMMISSIONERS

L 2002
6-4-66

WATER WELL DRILLERS LOG

Date: June 4, 1966, Driller: Ed Jones County: Claiborne
(Name)

| (1) Owner of Land: | Description & Color of Materials Sand, Clay, Red Clay, Shell, etc. | Thick- ness Feet | Depth Feet |
|--|---|------------------------|---------------|
| <u>Sam Alexander</u> (Name) <u>Rt 1 - Box 128 Post Gibson</u> (Address) | <u>Brown Sdy Cl</u> | <u>0</u> | <u>10</u> |
| (2) Location: <u>1/4</u> , <u>1/4</u> , Sec. <u>20 16R2E</u> | <u>Grey Cl</u> | <u>10</u> | <u>20</u> |
| <u>3</u> miles <u>E</u> of <u>Russell</u> (distance) (direction) (Nearest Town) | <u>Sd</u> | <u>22</u> | <u>22</u> |
| (3) Topography: <u>Hilly</u> | <u>Dry Cl</u> | <u>22</u> | <u>30</u> |
| (4) Purpose of Well: <u>Home & Cafe</u> (Domestic Irrigation, Municipal, Industrial, Other) | <u>Sandy</u> | <u>30</u> | <u>40</u> |
| Information upon completion of well: | <u>Blue Cl</u> | <u>40</u> | <u>50</u> |
| (1) Diameter: <u>4 1/2</u> inches. | <u>Bl Cl</u> | <u>50</u> | <u>60</u> |
| (2) Total Depth: <u>145</u> feet. | <u>Bl Cl</u> | <u>60</u> | <u>70</u> |
| (3) Water Level: <u>134'</u> feet below top of ground. | <u>Bl & Brown Cl</u> | <u>70</u> | <u>80</u> |
| (4) Cased to: <u>135'</u> Size: <u>2"</u> | <u>Blue Cl</u> | <u>90</u> | <u>100</u> |
| (5) Screen: Size: <u>80</u> , Length: <u>10'</u> | <u>Bl Sdy Cl - Sand</u> | <u>110</u> | <u>120</u> |
| (6) Were any formations sealed against pollution? | <u>Sd - (Chatter)</u> | <u>120</u> | <u>130</u> |
| <input checked="" type="checkbox"/> yes, <input type="checkbox"/> no. | <u>Sd (7 iron)</u> | <u>130</u> | <u>140</u> |
| If YES depth of formation _____ | <u>Sd - (7 iron)</u> | <u>140</u> | <u>145</u> |
| Why _____ | | | |
| Drillers Remarks: | | | |
| <u>B-K powder added</u> | | | |
| <u>To drilling mud</u> | | | |

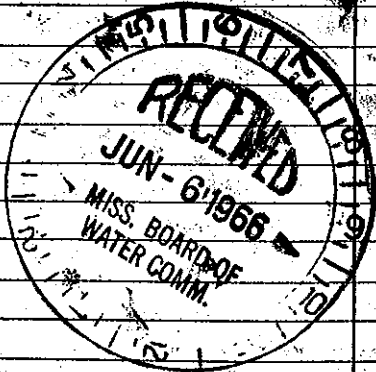

Well No

(Use Back Side)

Mail this copy to Board of Water Commissioners 429 Miss. St. Jackson, Miss.