

Claborn  
L 2003  
8-6-66

MISSISSIPPI BOARD OF WATER COMMISSIONERS

WATER WELL DRILLERS LOG


Date Aug 4, 1966, Driller E B Jon County Claborn  
(Name)

(1) Owner of Land: <u>Bailey</u> (Name) <u>Russum, Min</u> (Address)	Description & Color of Materials Sand, Clay, Red Clay, Shell, etc.	Thick- ness Feet	Depth Feet
	<u>Brown sdy cl</u>	<u>0</u>	<u>34</u>
	<u>Sd + Brown</u>	<u>34</u>	<u>38</u>
(2) Location: <u>1/4</u> , <u>1/4</u> , Sec <u>63 NW 24</u>	<u>Brown + White Cl</u>	<u>38</u>	<u>43</u>
<u>4</u> miles <u>South</u> of <u>St John</u> (distance) (direction) (Nearest Town)	<u>Sd + Brown</u>	<u>43</u>	<u>62</u>
(3) Topography: <u>Flat</u> (Hilly) (Flat) (Level)			
(4) Purpose of Well: <u>Domestic</u> (Domestic Irrigation Municipal, Industrial, Other)			

Information upon completion of well:

- (1) Diameter 4" inches.
- (2) Total Depth 62 feet.
- (3) Water Level 30 feet below top of ground.
- (4) Cased to 62, Size 2"
- (5) Screen: Size 2", Length 5'
- (6) Were any formations sealed against pollution?  
\_\_\_\_\_ yes, \_\_\_\_\_ no.

If YES depth of formation \_\_\_\_\_  
Why \_\_\_\_\_  
Drillers Remarks: \_\_\_\_\_

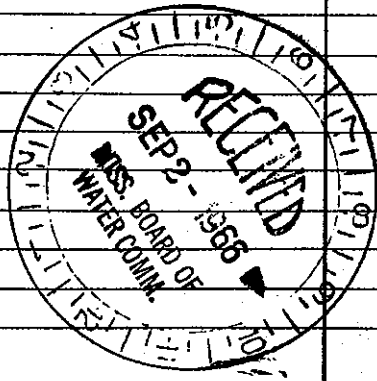

Well No.

(Use Back Side)

Mail this copy to Board of Water Commissioners 429 Miss. St. Jackson, Miss.