

Claiborne

MISSISSIPPI BOARD OF WATER COMMISSIONERS

L 2004
10-66

WATER WELL DRILLERS LOG

Date: Oct, 1966, Driller: E B Fore County Claiborne

(Name)

(1) Owner of Land:	Description & Color of Materials Sand, Clay, Red Clay, Shell, etc.	Thick- ness Feet	Depth Feet
<u>L J Page</u> (Name)	<u>Brown Shy Cl</u>	<u>40</u>	<u>40</u>
<u>Rt 1-Box 133 Pathfork</u> (Address)	<u>Blue Clay</u>	<u>83</u>	<u>123</u>
	<u>Sand</u>	<u>57</u>	<u>180</u>
(2) Location: <u>1/4</u> , <u>1/4</u> , Sec. <u>52 11 N 24 E</u>			
<u>5</u> miles <u>E</u> , <u>Parsippany</u> (distance) (direction) (Nearest Town)			
(3) Topography: <u>Hilly</u> (Hilly) (Flat) (Level)			
(4) Purpose of Well: <u>Domestic</u> (Domestic Irrigation Municipal, Industrial, Other)			

Information upon completion of well:

- (1) Diameter 4 inches.
- (2) Total Depth 180 feet.
- (3) Water Level 117 feet below top of ground.
- (4) Cased to 165, Size 2
- (5) Screen: Size .07 2", Length 15'
- (6) Were any formations sealed against pollution?
no

If YES depth of formation _____


Why _____

Drillers Remarks: _____

H.T.H. Tablets Added

Owner will cement

slab

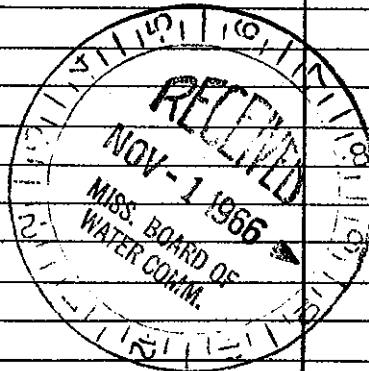

(Use Back Side)

Well No.

Mail this copy to Board of Water Commissioners 429 Miss. St. Jackson, Miss.