

Claiborne
 L2005
 5-67

MISSISSIPPI
 BOARD OF WATER COMMISSIONERS
 416 North State Street
 Jackson, Mississippi 39201

WATER WELL DRILLERS LOG

May 31 1967 EB FOR E Claiborne
 date well completed firm name county well located


LANDOWNER: LK Ashley
 Box 26
 Port Gibson, Miss
 (mailing address)

WELL LOCATION:
 sec. 1 T. 10 N R. 2 E
 7 miles SE of Port Gibson
 (distance) (direction) (nearest town)

WELL PURPOSE: Home
 (home, irrigation, municipal, industrial)

- WELL COMPLETION DATA:
- (1) diameter (inches) 4 1/4
 - (2) total depth (feet) 180
 - (3) static water level (feet) 108 below top of ground.
 - (4) casing Galv. 175 (material) (depth)
 No (size) if telescope see back.
 - (5) screen 6 175 (length) (depth to top)
 2" 55 (size) (material)
 - (6) pump 1 6 (HP) (yield gpm)
 Elec (type power)
 - (7) electric log No (yes or no)
 NONE (organization running log)
 - (8) how well bottom plugged Backfilled & clean

description of formations encountered	from	to
Brown Silty Clay	0	13
White Cl. Soft	13	15
White + Brown Cl Hard	15	23
White Sd.	23	24
White Cl + Sd Rock Strata	24	33
Grey Cl	33	40
Blue Cl	40	60
Grey + White Cl. Sd Strata	60	73
Cl + Sd Strata	73	78
White Sd - fine	78	83
Sd. med.	83	108
Blue Cl	108	112
Blue Sd - fine	112	114
Clay	114	122
Silty Cl	122	125
Sd - (fine)	125	128
Cl - Sd - Strata	128	138
Same	138	145
Sand	145	153
Sd + Cl Strata	153	158
Sd - fine	158	163
Clay + Sd	163	174
Grey Sd - Course	174	180
8" Slot Strainer		

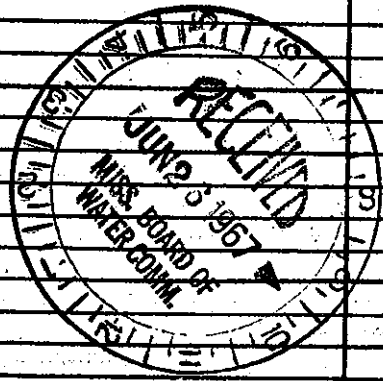

DRILLERS REMARKS: