

Claiborne  
L 2506  
7-67

MISSISSIPPI  
BOARD OF WATER COMMISSIONERS  
416 North State Street  
Jackson, Mississippi 39201

WATER WELL DRILLERS LOG

July 27 1967 EB FORE Claiborne  
date well completed firm name county well located

LANDOWNER: JAMES W. CANN  
Rt 1 - Box 28  
Port Gibson, Miss  
(mailing address)

WELL LOCATION:  
sec. 4 T. 11 N. R. 2 E. Miss.  
S. 0 miles 0 of Russum  
(distance) (direction) (nearest town)

WELL PURPOSE: Home  
(home, irrigation, municipal, industrial)

WELL COMPLETION DATA:

(1) diameter (inches) 4 1/2

(2) total depth (feet) 90

(3) static water level (feet) 40 below  
top of ground.

(4) casing Galv 85'  
(material) (depth)

NO if telescope see back.  
(size)

(5) screen 5" 85'  
(length) (depth to top)

2" SS  
(size) (material)

(6) pump 1 12  
(HP) (yield gpm)


Elec  
(type power)

(7) electric log NO  
(yes or no)

None  
(organization running log)

Backwash valve  
(8) how well bottom plugged

description of formations encountered	from	to
<u>Brown silty clay</u>	<u>0</u>	<u>23</u>
<u>Sand + gravel</u>	<u>23</u>	<u>31</u>
<u>Blue clay</u>	<u>31</u>	<u>70</u>
<u>Sand</u>	<u>70</u>	<u>90</u>

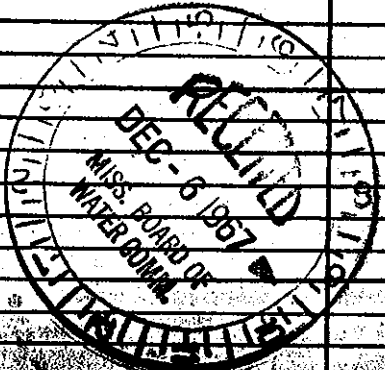

DRILLERS REMARKS: