

Claiborne
 L2007
 2-68

MISSISSIPPI
 BOARD OF WATER COMMISSIONERS
 416 North State Street
 Jackson, Mississippi 39201

WATER WELL DRILLERS LOG

2-15 1968 E B Fore Claiborne
 date well completed firm name county well located

LANDOWNER: W.C.
 Treuillion
 Hwy 61 - S. Pt Gibson Miss
 (mailing address)


description of formations encountered	from	to
Brown Sd @	0	15
Brown + White @	15	40
Blue @	40	70
Sand -	60	110

WELL LOCATION:
 sec. 44 T 11 N R 2 E
 4 miles S Pt Gibson
 (distance) (direction) (nearest town)

WELL PURPOSE: HOME -
 (home, irrigation, municipal, industrial)

WELL COMPLETION DATA:

(1) diameter (inches) 4 1/4
 (2) total depth (feet) 110
 (3) static water level (feet) 70 below top of ground.
 (4) casing GALV 105' (material) (depth)
 (size) if telescope see back.
 (5) screen 2' 105' (length) (depth to top)
 2" (size) SS steel (material)
 (6) pump 1 4 (HP) (yield gpm)
 Elec (type power)
 (7) electric log No (yes or no)
 None (organization running log)
 B.W. Valve -
 (8) how well bottom plugged

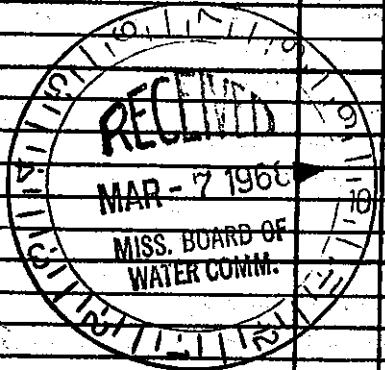

DRILLERS REMARKS: