

Claiborne
 L2008
 4-67

MISSISSIPPI
 BOARD OF WATER COMMISSIONERS
 416 North State Street
 Jackson, Mississippi 39201

WATER WELL DRILLERS LOG

4-1 1967 EBFORÉ Claiborne
 date well completed firm name county well located

LANDOWNER: <u>Freddie Lee Jones</u> <u>Port Gibson Miss</u> (mailing address)	description of formations encountered	from	to
	Brown Sh. Cl	0	44
	Sd + Gravel	44	48
	Sd	48	50
	Brown + White Clay	50	98
	Sd	98	104
	Sd Rock	104	110
	Blue Clay + Rock Str.	110	165
	Sd -	165	200


WELL LOCATION:
 sec. 8 T 11 N R. 2 E
3 1/2 miles SW of Port Gibson
 (distance) (direction) (nearest town)

WELL PURPOSE: Home
 (home, irrigation, municipal, industrial)

WELL COMPLETION DATA:

- (1) diameter (inches) 4 1/4"
- (2) total depth (feet) 200
- (3) static water level (feet) 146 ^{below}/_{above} top of ground.
- (4) casing Galv. 190
 (material) (depth)
 _____ if telescope see back.
 (size)
- (5) screen 10 190
 (length) (depth to top)
80 gpm 2" BRASS
 (size) (material)
- (6) pump 1 1/2 6
 (HP) (yield gpm)
Elec
 (type power)
- (7) electric log No
 (yes or no)

 (organization running log)
- (8) new well bottom plugged
Backwash valve

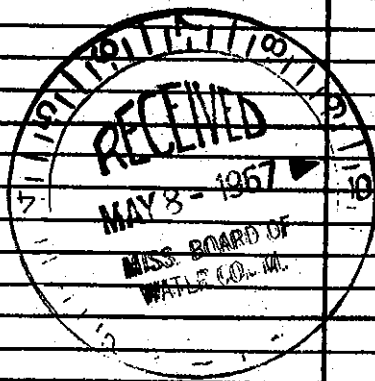

DRILLERS REMARKS: