

Claiborne
 L2009
 4-67

MISSISSIPPI
 BOARD OF WATER COMMISSIONERS
 416 North State Street
 Jackson, Mississippi 39201

WATER WELL DRILLERS LOG

4-16 67 EB Fore Claiborne
 date well completed firm name county well located

LANDOWNER: Mr & K DeWitt
 Hwy 61 - South -
 Port Gibson, Miss
 (mailing address)


description of formations encountered	from	to
Brown Sdy Cl	0	33
White Cl & Brown	33	45
Blue Cl	45	100
Sd & Cl streaks	100	110
---	110	120
---	120	122
Sd White fine	122	130
Sd Coars. w/	130	143
Cl & Sd	145	150
Sd - fine	150	160
Sd - Coarsen	161	165
S. sh	165	170

WELL LOCATION:
 sec. 45 T 11 N R 2 E
 4 miles S of Gibson
 (distance) (direction) (nearest town)

WELL PURPOSE: Home
 (home, irrigation, municipal, industrial)

WELL COMPLETION DATA:

(1) diameter (inches) 6 1/2
 (2) total depth (feet) 175
 (3) static water level (feet) 108 below top of ground.
 (4) casing Plastic 160 (material) (depth)
 4" (size) if telescope see back.
 (5) screen 15 160 (length) (depth to top)
 4" Plastic (size) (material)
 (6) pump 3/4 20 (HP) (yield gpm)
 Elec (type power)
 (7) electric log (yes or no)
 (organization running log)
 (8) how well bottom plugged Backwash valve

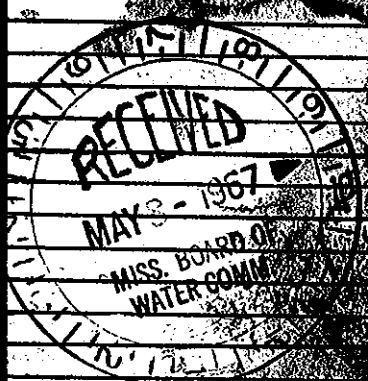

DRILLERS REMARKS: