

Claihome  
L2016  
8-68

MISSISSIPPI  
BOARD OF WATER COMMISSIONERS  
416 North State Street  
Jackson, Mississippi 39201

WATER WELL DRILLERS LOG

Aug 1968 EB Jew Claihome  
date well completed firm name county well located


LANDOWNER: R.A. Segrest  
Hwy 61 S -  
Port Gibson Miss -  
(mailing address)

WELL LOCATION:  
sec 53 T 11 N R 2 E  
4 miles S Pt Bickin  
(distance) (direction) (nearest town)

WELL PURPOSE: Home  
(home, irrigation, municipal, industrial)

WELL COMPLETION DATA:  
(1) diameter (inches) 4 1/4  
(2) total depth (feet) 185  
(3) static water level (feet) 87 below top of ground  
(4) casing Galv, 175 (material) (depth)  
If telescope see back.  
(size)  
(5) screen 10, 175 (length) (depth to top)  
2", 53- (size) (material)  
(6) pump 1 1/2, 10 (HP) (yield gpm)  
Elec (type power)  
(7) electric log No (yes or no)  
None (organization running log)  
(8) how well bottom plugged B.W. Value

description of formations encountered	from to	
Brown Sh. Cl	0	30
Sand & Gravel	30	40
Blue Cl - sd Strub	40	150
Sand	150	185

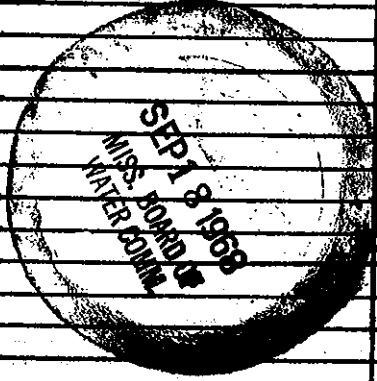

DRILLERS REMARKS: