

Claiborne  
117  
11-66

MISSISSIPPI BOARD OF WATER COMMISSIONERS ELOG # 59

WATER WELL DRILLERS LOG

CODED

Date: Nov 25, 1966, Driller: E B Fore County: Claiborne

(Name)

(1) Owner of Land: <u>Herman Early</u> (Name)	Description & Color of Materials Sand, Clay, Red Clay, Shell, etc.	Thick- ness Feet	Depth Feet
<u>Rt - 1 Port Gibson</u> (Address)	<u>Brown Sdy clay</u>	<u>15</u>	<u>15</u>
<u>Box J-40</u> (Address)	<u>white clay</u>	<u>18</u>	<u>33</u>
(2) Location: <u>SW 1/4, 1/4, Sec. 7 T03R5E</u>	<u>Blue clay with few sand rock</u>		
<u>10 miles SE Port Gibson</u> (distance) (direction) (Nearest Town)	<u>streak</u>	<u>70</u>	<u>103</u>
(3) Topography: <u>Hilly</u> (Hilly) (Flat) (Level)	<u>Fine sand</u>		
(4) Purpose of Well: <u>Domestic</u> (Domestic Irrigation Municipal, Industrial, Other)	<u>with a few clay streak</u>	<u>153</u>	<u>256</u>


Information upon completion of well:

- (1) Diameter 4 1/4 inches.
- (2) Total Depth 256 feet.
- (3) Water Level  feet below top of ground.
- (4) Cased to  , Size
- (5) Screen: Size  , Length
- (6) Were any formations sealed against pollution?  
 yes,  no.

Logged by  
Miss. Geo. Survey

If YES depth of formation \_\_\_\_\_  
Why \_\_\_\_\_

Drillers Remarks: These people  
didn't want to spend  
enough money to  
develop well

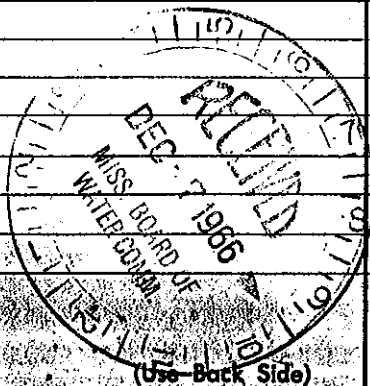

Well No

Mail this copy to Board of Water Commissioners 429 Miss. St. Jackson, Miss.