

Clairborne

MISSISSIPPI BOARD OF WATER COMMISSIONERS

M 2000
8-2-66

WATER WELL DRILLERS LOG

Date: Aug 2, 1966, Driller: EBF J. v. e County: Clairborne
(Name)

(1) Owner of Land (Name)	Description & Color of Materials Sand, Clay, Red Clay, Shell, etc.	Thick- ness Feet	Depth Feet
John Ehhis Port Gibson, Miss Rt. 13, Sugar 10 1/2	Dr. Shy Cl WhiteACL Sd + gravel	0 20 25 60	20 25 60
(2) Location: 1/4, 1/4, Sec. 28 T11 R3E 4 miles NE E of Port Gibson (distance) (direction) (Nearest Town)			
(3) Topography: Hilly (Hilly) (Flat) (Level)			
(4) Purpose of Well: Domestic (Domestic Irrigation Municipal, Industrial, Other)			


Information upon completion of well:

- (1) Diameter: 2 inches.
- (2) Total Depth: 63 feet.
- (3) Water Level: 33 feet below top of ground.
- (4) Cased to: 63, Size: 2
- (5) Screen: Size: 2, Length: 4
- (6) Were any formations sealed against pollution?
yes, no.

If YES depth of formation

Why

Drillers Remarks:

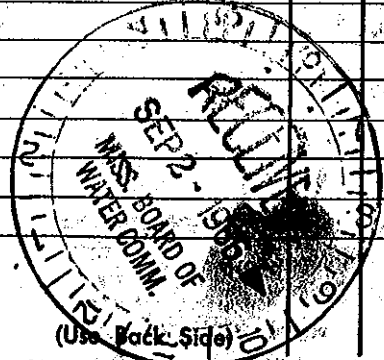

Well No.

Mail this copy to Board of Water Commissioners 429 Miss. St. Jackson, Miss.