

Claiborne

M2001

4-67

MISSISSIPPI
 BOARD OF WATER COMMISSIONERS
 416 North State Street
 Jackson, Mississippi 39201

WATER WELL DRILLERS LOG

4-20

W. E. R. Jones


Claiborne

date well completed

firm name

county well located

LANDOWNER	description of formations encountered	from	to
Mrs Mary Trim	Brown Silty Cl	0	15
Rt Box 103 - Port Gibson	Blk Cl & Shale	15	25
(mailing address)	Sd Brown	25	28
WELL LOCATION:		28	37
sec. 28 T. 11 N. R. 3 E	Cl	37	43
5 miles SE of Port Gibson	Sd Brown	43	60
(distance) (direction) (nearest town)	Blk Cl	60	61
WELL PURPOSE: Home	Sd	61	70
(home, irrigation, municipal, industrial)	Cl	70	73
WELL COMPLETION DATA:	Sd	73	75
(1) diameter (inches) 4 1/4	Cl	75	77
(2) total depth (feet) 111	Sd	77	110
(3) static water level (feet) 30 below top of ground.			
(4) casing Galv. 105'			
(material) (depth)			
(size) if telescope see back.			
(5) screen 6' 105'			
(length) (depth to top)			
2" Brass			
(size) (material)			
(6) pump 1 6'			
(HP) (yield gpm)			
Elec			
(type power)			
(7) electric log No			
(yes or no)			
(organization running log)			
(8) how well bottom plugged Backwash Valve			

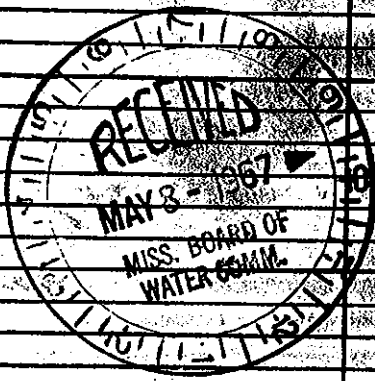

DRILLERS REMARKS: