

Clairborne

M2002

12-67

MISSISSIPPI  
 BOARD OF WATER COMMISSIONERS  
 416 North State Street  
 Jackson, Mississippi 39201

WATER WELL DRILLERS LOG

12-2

1967 EB Fore

Clairborne

date well completed

firm name

county well located

LANDOWNER: Mary Baker

description of formations encountered

from to

Hwy 18 E - R2D.

Post Gibson Min  
(mailing address)

Brown Sls Cl

0 13

Grey Clay

13 30

WELL LOCATION:

sec. 4 T 11 N R 3 E

Brown Sand

20 30

6 miles E of Gibson  
(distance) (direction) (nearest town)

Sand

30 81

WELL PURPOSE: Home  
(home, irrigation, municipal, industrial)

WELL COMPLETION DATA:

(1) diameter (inches) 4 1/4

(2) total depth (feet) 81

(3) static water level (feet) 28 below top of ground.

(4) casing Galv 76  
(material) (depth)

No if telescope see back.  
(size)

(5) screen 5' 76  
(length) (depth to top)

2" 55  
(size) (material)


(6) pump 1 6  
(HP) (yield gpm)

Elec  
(type power)

(7) electric log No  
(yes or no)

None  
(organization running log)

(8) All Well bottom plugged

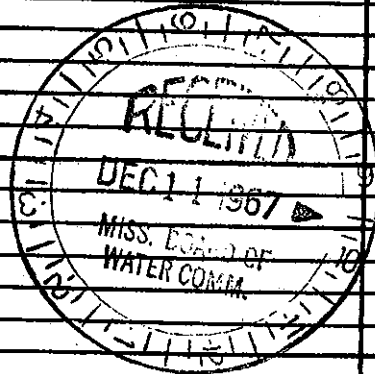

DRILLERS REMARKS: