

Clairborne  
 M 2053  
 12-67

MISSISSIPPI  
 BOARD OF WATER COMMISSIONERS  
 416 North State Street  
 Jackson, Mississippi 39201

WATER WELL DRILLERS LOG


12-3 1967 EB Fore Clairborne  
 date well completed firm name county well located

LANDOWNER: James Banks Hwy 18 E R 2 D Port Gibson, Miss (mailing address)	description of formations encountered	from	to
	Brown Sh, Cl	0	13
	Grey Clay	13	20
	Brown Sand	20	30
	Sand	30	81

WELL LOCATION:  
 sec. 4 T 11 N R 3 E  
 6 miles E Port Gibson  
 (distance) (direction) (nearest town)

WELL PURPOSE: Home  
 (home, irrigation, municipal, industrial)

WELL COMPLETION DATA:  
 (1) diameter (inches) 4 1/4"  
 (2) total depth (feet) 81  
 (3) static water level (feet) 28' below top of ground.  
 (4) casing Galv 76 (material) (depth)  
 No (size) if telescope see back.  
 (5) screen 5' 74 (length) (depth to top)  
 2" 55 (size) (material)  
 (6) pump 1 (HP) 6 (yield gpm)  
 Elec (type power)  
 (7) electric log No (yes or no)  
 None (organization running log)  
 how well bottom plugged

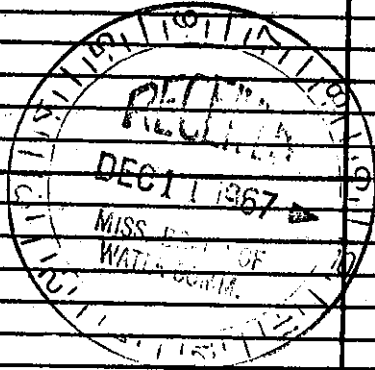

DRILLERS REMARKS: