

N 21
7-24-61


WATER WELL DRILLERS LOG **CODED**

Date: 7/24, 1961, Driller: James McGee County ClaiBORNE
(Name)

126

	Description & Color of Materials Sand, Clay, Red Clay, Shell, etc.	Thick- ness Feet	Depth Feet
(1) Owner of Land: <u>Mrs. D. E. Bannerman</u> (Name)	Clay.	0-	36
<u>Hermanville, Miss.</u> (Address)	Hard Blue clay.	36-	74
(2) Location: <u>4 11 9E</u> <u>13 7/2 R 4E</u>	Mucky sand.	74-	82
This place located about 4 miles	Mucky sand & stks. clay.	82-	93
East of Hermanville on old Hazel-	Mucky sand & stks. rock.	93-	97
hurst road. (distance) (direction) (Nearest Town)	Clay.	97-	102
(3) Topography: <u>x</u> (Hilly) (Flat) (Level)	Hard clay.	102-	142
(4) Purpose of Well: <u>Domestic.</u> (Domestic Irrigation Municipal, Industrial, Other)	Clay & rock.	142-	152
	Hard clay.	152-	170
	Packed sand & rock.	170-	177
	Clay.	177-	298
Information upon completion of well:	Rock.	298-	302
(1) Diameter <u>2</u> inches.	Hard clay & stks. rock.	302-	327
(2) Total Depth <u>382</u> feet.	Clay & stks. sand.	327-	339
(3) Water Level <u>136'</u> feet below top of ground.	Hard clay.	339-	367
(4) Cased to <u>367'</u> , Size <u>2"</u>	Fine sand. (Screen set)	367-	382
(5) Screen: Size <u>2"</u> , Length <u>15'</u>			
(6) Were any formations sealed against pollution? <u>no.</u>			
If YES depth of formation _____			
Why _____			
Drillers Remarks: <u>Fair well.</u>			

CODED

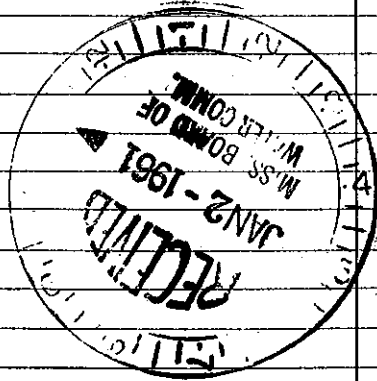

Well No.

(Use Back Side)

Retain this copy for your office files.