

CLAIBORNE MISSISSIPPI BOARD OF WATER COMMISSIONERS

~~102~~ N22

WATER WELL DRILLERS LOG **CODED**

5-25-62

Date: 5/25, 1962, Driller: Johnnie Beasley County Claiborn  
1017 (Name)

|   | Description & Color of Materials<br>Sand, Clay, Red Clay, Shell, etc. | Thick-<br>ness<br>Feet | Depth<br>Feet |
|---|---|------------------------|---------------|
| (1) Owner of Land: Mrs. Carrine Ietteroff<br>(Name)                                     | Brown silt.   | 10                     | 10            |
| Hermonville, Miss.<br>(Address)   | Sand & stks. clay.  | 40                     | 50            |
| (2) Location: 1/4, 1/4, Sec. 5 T. 11 R. 46  | Sand.   | 10                     | 60            |
| _____ miles _____, of _____<br>(distance) (direction) (Nearest Town)                    | Coarse sand   | 21                     | 81            |
| (3) Topography: x<br>(Hilly) (Flat) (Level)   | Blue clay.  | 38                     | 119           |
| (4) Purpose of Well: Domestic.<br>(Domestic Irrigation<br>Municipal, Industrial, Other) | Sand & stks. shale.   | 11                     | 130           |
|   | Sand. (Screen setting.)   | 16                     | 146           |

**CODED**


Information upon completion of well:

- (1) Diameter 2" inches.
- (2) Total Depth 146 feet.
- (3) Water Level 47 feet below top of ground.
- (4) Cased to 136', Size 2"
- (5) Screen: Size 2", Length 10'
- (6) Were any formations sealed against pollution?  
\_\_\_\_\_ yes, \_\_\_\_\_ x no.

If YES depth of formation \_\_\_\_\_

Why \_\_\_\_\_

Drillers Remarks: Fair well.

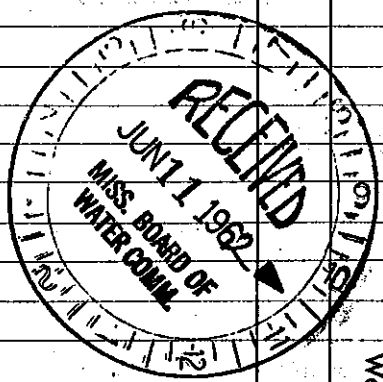

(Use Back Side)

Well No.

Mail this copy to Board of Water Commissioners 429 Miss. St. Jackson, Miss