

N 23

11-19-62

WATER WELL DRILLERS LOG

**CODED**

Date: Nov. 19, 1962, Driller: Burney Water Well Service, County: Claiborne

131

(Name)

(1) Owner of Land: Mr. Milton Bruce  
 (Name)  
Hermanville, Miss.  
 (Address)  
Hazlehurst - Hermanville Road  
 (2) Location: 1/4, 1/4, Sec. 13 T11 R9E  
17  
1 1/2 miles South of Hermanville  
 (distance) (direction) (Nearest Town)  
 (3) Topography: Hilly  
 (Hilly) (Flat) (Level)  
 (4) Purpose of Well: Domestic  
 (Domestic Irrigation  
 Municipal, Industrial, Other)

Description & Color of Materials Sand, Clay, Red Clay, Shell, etc.	Thick- ness Feet	Depth Feet
Topsoil	18	18
Gravel bed	2	20
Yellow & grey clay	18	38
Rock	2	40
Blue clay	5	45
Hard formation	6	51
Brown Formation	9	60
Fine sand layers	5	65
Blue clay	18	83
Sand layers	5	88
Black & Yellow clay	4	102
Sand	8	110
Clay layers	8	118
Blue clay	17	135
Sand	3	138
Shale	4	142

Information upon completion of well:

(1) Diameter 6 inches.

(2) Total Depth 142 feet.

(3) Water Level 79 feet below top of ground.

(4) Cased to 116', Size 4"

(5) Screen: Size 2 1/2", Length 10'


(6) Were any formations sealed against pollution?  
 yes,  no.

If YES depth of formation      from surface

Why used Sanitary well seal

Drillers Remarks:     

**CODED**

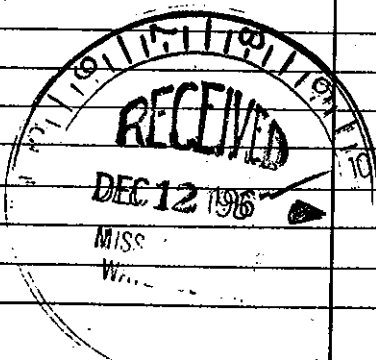

(Use Back Side)

Well No.

Mail this copy to Board of Water Commissioners 429 Miss. St. Jackson, Miss.