

Claiborne

N 2004

2-67

MISSISSIPPI  
 BOARD OF WATER COMMISSIONERS  
 416 North State Street  
 Jackson, Mississippi 39201

WATER WELL DRILLERS LOG

2-25 67 E B FORE

Claiborne

date well completed

firm name

county well located

LANDOWNER: Arthur-Phelps

description of formations encountered

from to

Box 194

Brown Sdy Cl

0 22

Hermanville, Miss

White Cl

22 33

(mailing address)

Blue Cl

33 65

WELL LOCATION:

Sd fine

65 78

sec 20 T 11 N R 4 E

Cl Blue

78 130

4 miles SW Hermanville

WELL PURPOSE: Home

(home, irrigation, municipal, industrial)

WELL COMPLETION DATA:

(1) diameter (inches) 4"

(2) total depth (feet) 130'

(3) static water level (feet) 32' below top of ground.

(4) casing Galv 74'

1 1/4" (size) If telescope see back.

(5) screen 6' 74'

80 1 1/4" Brass (size) (material)


(6) pump 1 (HP) 10 (yield gpm)

Elec (type power)

(7) electric log no (yes or no)

(organization running log)

8) how well bottom plugged

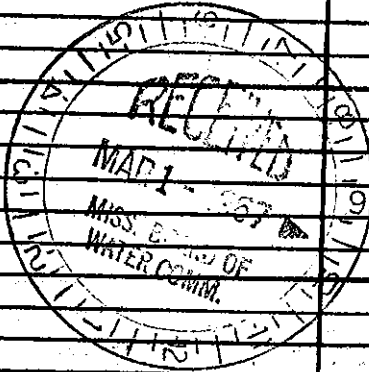

DRILLERS REMARKS: