

Claiborne

N 2005

2-68

MISSISSIPPI
 BOARD OF WATER COMMISSIONERS
 416 North State Street
 Jackson, Mississippi 39201

WATER WELL DRILLERS LOG

2-28

W E B F O R E D r I C o. Claiborne

date well completed

firm name

county well located

LANDOWNER: Wess Ellis

description of formations encountered

from to

Rt 2-

Hermanville, Miss.

(mailing address)

Brown Clay 0 20

White Clay 20 28

White Sand 28 66


WELL LOCATION:

sec. 16 T 11 N R 4 E
4 miles SE Hermanville
 (distance) (direction) (nearest town)

WELL PURPOSE: Home
 (home, irrigation, municipal, industrial)

WELL COMPLETION DATA:

- (1) diameter (inches) 4 1/4"
- (2) total depth (feet) 66
- (3) static water level (feet) 50 below above top of ground.
- (4) casing Galv 61
(material) (depth)
(size) If telescope see back.
- (5) screen 5 61
(length) (depth to top)
.08 SS
(size) (material)
- (6) pump 1/2 Rod 4
(HP) (yield gpm)
Elec
(type power)
- (7) electric log No
(yes or no)
None
(organization running log)
- (8) Back wash Valve
How well bottom plugged

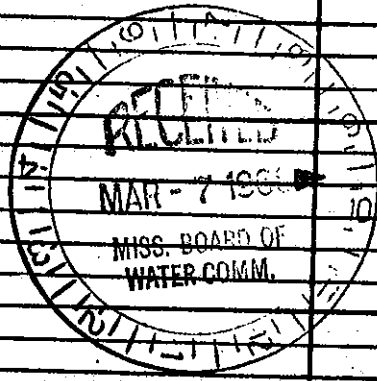

DRILLERS REMARKS: