

MISSISSIPPI
 BOARD OF WATER COMMISSIONERS
 416 North State Street
 Jackson, Mississippi 39201

WATER WELL DRILLERS LOG

Clairborne
 1/2006
 68

8-1 1968 Ed Jones Clairborne
 date well completed firm name county well located


LANDOWNER: D.A. Newman
 Box 124
 Pattison Miss
 (mailing address)

description of formations encountered	from	to
Brown clay cl & sand	0	60
Sandy cl	60	80
Sand	80	90

WELL LOCATION:
 sec. 43 T 11 N R 4 E
 8 miles E of Pattison
 (distance) (direction) (nearest town)

WELL PURPOSE: Home
 (home, irrigation, municipal, industrial)

- WELL COMPLETION DATA:
- (1) diameter (inches) 6 1/2"
 - (2) total depth (feet) 91
 - (3) static water level (feet) 50 below top of ground.
 - (4) casing Plastic 89 (material) (depth)
 (size) If telescope see back.
 - (5) screen 6 89 (length) (depth to top)
 4" Plastic (size) (material)
 - (6) pump 3/4 6 (HP) (yield gpm)
 Elec (type power)
 - (7) electric log No (yes or no)
 None (organization running log)
 - (8) how well bottom plugged BWU

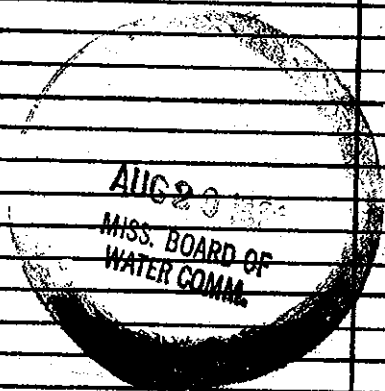

DRILLERS REMARKS: