

CLAIBORNE MISSISSIPPI BOARD OF WATER COMMISSIONERS

2000

WATER WELL DRILLERS LOG

2000

Date: 10-5-60, 1960, Driller: Herring Jewell County Claiborne
 (Name)

(1) Owner of Land:	Description & Color of Materials Sand, Clay, Red Clay, Shell, etc.	Thick- ness Feet	Depth Feet
<u>SAM E. Sorrels</u> (Name) <u>Port Gibson, Miss.</u> (Address)	<u>Red Clay</u>	<u>15'</u>	<u>15'</u>
(2) Location: <u>1/4</u> , <u>1/4</u> , Sec. <u>9</u> <u>W46</u>	<u>Clay</u>	<u>30'</u>	<u>45'</u>
<u>12 1/2</u> miles <u>East</u> , of <u>Port Gibson</u> (distance) (direction) (Nearest Town)	<u>Sand</u>	<u>15'</u>	<u>60'</u>
(3) Topography: <input checked="" type="checkbox"/> (Hilly) <input type="checkbox"/> (Flat) <input type="checkbox"/> (Level)	<u>Clay</u>	<u>50'</u>	<u>110'</u>
(4) Purpose of Well: <u>Domestic</u> (Domestic Irrigation Municipal, Industrial, Other)	<u>SAND</u>	<u>58'</u>	<u>168'</u>


Information upon completion of well:

- (1) Diameter 4 3/4 inches.
- (2) Total Depth 168 feet.
- (3) Water Level 80' feet below top of ground.
- (4) Cased to 163', Size 2"
- (5) Screen: Size 2", Length 5'
- (6) Were any formations sealed against pollution?
 yes, no.

If YES depth of formation _____

Why _____

Drillers Remarks: _____

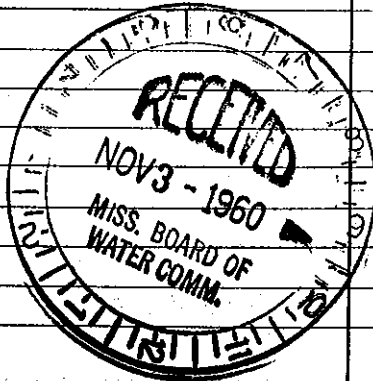

Well No. _____

(Use Back Side)

Mail this copy to Board of Water Commissioners 429 Miss. St. Jackson, Miss.