

Clairborne

O 2001

11-67

MISSISSIPPI
 BOARD OF WATER COMMISSIONERS
 416 North State Street
 Jackson, Mississippi 39201

WATER WELL DRILLERS LOG

Nov 2
date well completed

EB Fore
firm name

Clairborne
county well located

LANDOWNER: M.W. Kuthaug
Pattison

description of formations encountered	depth	
	from	to
Brown Sand	0	40
Sand	40	120


F. J. K. Pattison, Miss.
(mailing address)

WELL LOCATION:
 sec. 14 T. 10 N R. 4 E
 14 miles SE of Port Gibson
 (distance) (direction) (nearest town)

WELL PURPOSE: Home
(home, irrigation, municipal, industrial)

WELL COMPLETION DATA:

- (1) diameter (inches) 6 1/2"
- (2) total depth (feet) 120
- (3) static water level (feet) 42" below top of ground.
- (4) casing Plastic, 106' (material) (depth)
- (size) If telescope see back.
- (5) screen 15' 106' (length) (depth to top)
4" Plastic (size) (material)
- (6) pump 1/2 12 (HP) (yield gpm)
Elec (type power)
- (7) electric log No (yes or no)
None (organization running log)
- (8) how well bottom plugged

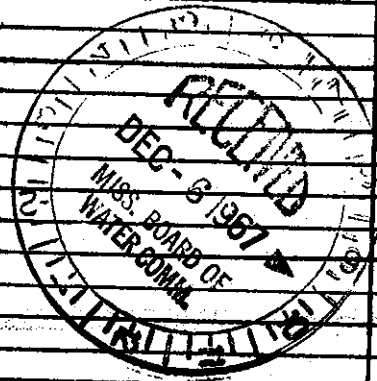

DRILLERS REMARKS: