

MISSISSIPPI
BOARD OF WATER COMMISSIONERS
416 North State Street
Jackson, Mississippi 39201

WATER WELL DRILLERS LOG

Claiborne
02002
11-67

Nov 4 1967 FB Fore Claiborne
date well completed firm name county well located

LANDOWNER: M.W. Kuhavey
R.F.D. Pattison, Miss
(mailing address)

description of formations encountered	from	to
<u>Brown Shy Cl</u>	<u>0</u>	<u>24</u>
<u>White Shy Cl + Sand</u>	<u>24</u>	<u>40</u>

WELL LOCATION:
sec. 14 T. 10 N R. 4 E
14 miles SE of Port Gibson
(distance) (direction) (nearest town)

<u>Blue clay</u>	<u>40</u>	<u>50</u>
<u>on sand</u>	<u>50</u>	<u>65</u>

WELL PURPOSE: Home
(home, irrigation, municipal, industrial)

WELL COMPLETION DATA:

(1) diameter (inches) 4 1/2"

(2) total depth (feet) 65

(3) static water level (feet) 32 below above top of ground.

(4) casing Galv 60
(material) (depth)

_____ If telescope see back.
(size)

(5) screen 5 60
(length) (depth to top)

2" SS
(size) (material)


(6) pump 1 10
(HP) (yield gpm)

Elec
(type power)

(7) electric log No
(yes or no)

_____ (organization running log)

(8) how well bottom plugged Backwash & clean

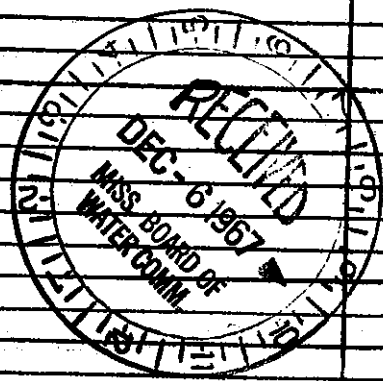

DRILLERS REMARKS: