

Claiborne
 O 2003
 11-67

MISSISSIPPI
 BOARD OF WATER COMMISSIONERS
 416 North State Street
 Jackson, Mississippi 39201

WATER WELL DRILLERS LOG


Nov 6 1967 E B Fore Claiborne
 date well completed firm name county well located

LANDOWNER: <u>W. F. Rushbrook</u> <u>RFD</u>	description of formations encountered	from	to
<u>Pattison, Miss</u> (mailing address)	<u>Brown sd, cl</u>	<u>0</u>	<u>20</u>
	<u>Brown sd</u>	<u>20</u>	<u>38</u>
	<u>Blue cl</u>	<u>38</u>	<u>68</u>
	<u>Sand -</u>	<u>68</u>	<u>90</u>

WELL LOCATION:
 sec. 10 T. 10 N R. 4 E
12 miles SE of Port Gibson
 (distance) (direction) (nearest town)

WELL PURPOSE: Home
 (home, irrigation, municipal, industrial)

- WELL COMPLETION DATA:
- (1) diameter (inches) 4 1/2"
 - (2) total depth (feet) 90'
 - (3) static water level (feet) 56' below top of ground.
 - (4) casing Galv 85'
(material) (depth)
 - _____ if telescope see back.
(size)
 - (5) screen 5' 85'
(length) (depth to top)
 - 2" SS
(size) (material)
 - (6) pump 1 7
(HP) (yield gpm)
 - Elec
(type power)
 - (7) electric log No
(yes or no)
 - _____ (organization running log)
 - (8) how well bottom plugged Backwash valve

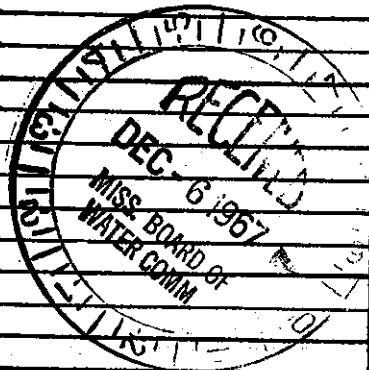

DRILLERS REMARKS: