

CLAIBORNE

02506

-68

4-1-68

MISSISSIPPI
BOARD OF WATER COMMISSIONERS
416 North State Street
Jackson, Mississippi 39201

WATER WELL DRILLERS LOG

ER FORE

Clairborne

date well completed

firm name

county well located

LANDOWNER: Annie Lee

description of formations encountered

from to

Travillion - Pobrny
Pattison, Miss
(mailing address)

Brown Clay

0 13

White Clay

13 15

WELL LOCATION:

sec. 9 T. 10 N R. 4 E
4 miles SE of Above
(distance) (direction) (nearest town)

White Sand-shal

15 23

Blue Clay

23 110

WELL PURPOSE: Home -
(home, irrigation, municipal, industrial)

Sandy Blue Clay

110 163

WELL COMPLETION DATA:

Sand - fine

163 180

(1) diameter (inches) 4 1/4
(2) total depth (feet) 200
(3) static water level (feet) 44 below top of ground.

Sand coarse

180 190

Sand med.

190 200

(4) casing CAW 190 -
(material) (depth)

No (size) if telescope see back.

(5) screen 10 180 -
(length) (depth to top)

2" (size) SS (material)


(6) pump (HP) (yield gpm)

Elec (type power)

(7) electric log No (yes or no)

None - (organization running log)

Backwash valve
(how well bottom plugged)

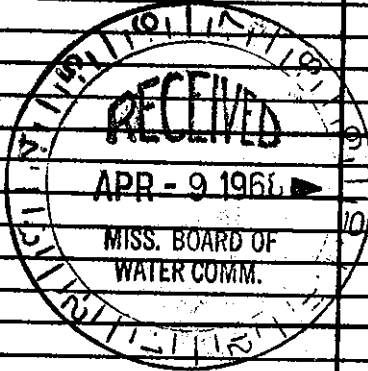

DRILLERS REMARKS: