

Clairborne
 02008
 2-68

MISSISSIPPI
 BOARD OF WATER COMMISSIONERS
 416 North State Street
 Jackson, Mississippi 39201

WATER WELL DRILLERS LOG

July 19 68 E. B. Dyer Clairborne
 date well completed firm name county well located

LANDOWNER: Aunie Lee
Irivillion Box 14
Pattison Miss.
 (mailing address)

WELL LOCATION:
 sec. 9 T. 10 N R. 4 E
4 miles S of Pattison
 (distance) (direction) (nearest town)

WELL PURPOSE: Home
 (home, irrigation, municipal, industrial)

WELL COMPLETION DATA:

(1) diameter (inches) 4 1/4

(2) total depth (feet) 200

(3) static water level (feet) 4 below above top of ground.

(4) casing Galv, 180,
 (material) (depth)
 (size) if telescope see back.


(5) screen 10, 180
 (length) (depth to top)
2, SS
 (size) (material)

(6) pump 1, 15
 (HP) (yield gpm)
Elec
 (type power)

(7) electric log No
 (yes or no)
NONE
 (organization running log)

(8) how well bottom plugged BW Dyer

description of formations encountered	from	to
<u>Brown Clay</u>	<u>0</u>	<u>12</u>
<u>White Cl & sd</u>	<u>13</u>	<u>23</u>
<u>Blue Clay</u>	<u>23</u>	<u>163</u>
<u>Sand</u>	<u>163</u>	<u>200</u>

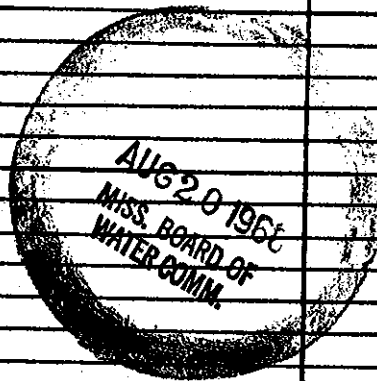

DRILLERS REMARKS: