

CLAIBORNE

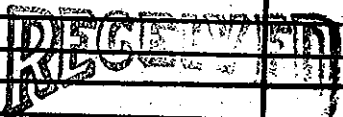
Φ 2010

1-12-76

MISSISSIPPI  
BOARD OF WATER COMMISSIONERS  
416 North State Street  
Jackson, Mississippi 39201

WATER WELL DRILLERS LOG

Jan. 12 1976 Grenn Wager well Con. Claiborne  
date well completed firm name county well located

LANDOWNER:	description of formations encountered	from	to
Ben Newman			
Pattison, Misss. 329144 (mailing address)	Sand	12	103
<b>WELL LOCATION:</b>			
sec. <u>28</u> T. <u>10</u> N R. <u>4</u> E S W			
<u>12</u> miles SE of <u>Pattison</u> (distance) (direction) (nearest town)			
<b>WELL PURPOSE:</b> <u>home</u> (home, irrigation, municipal, industrial)			
<b>WELL COMPLETION DATA:</b>			
(1) diameter (inches) <u>4</u>			
(2) total depth (feet) <u>108</u>			
(3) static water level (feet) <u>73</u> below above top of ground.			
(4) casing <u>PVC</u> <u>96'</u> (material) (depth) <u>4"</u> (size) if telescope see back.			
(5) screen <u>12'</u> <u>96'</u> (length) (depth to top) <u>.010</u> <u>PVC</u> (size) (material)			
(6) pump <u>1/3</u> sub <u>7</u> (HP) (yield gpm) <u>Electric</u> (type power)			
(7) electric log <u>no</u> (yes or no)  (organization running log)			
(8) how well bottom plugged <u>wood</u>			
<b>DRILLERS REMARKS:</b>			
 MAY 7 1976 MISS. BD. OF WATER COMM			