


Clarke
2 A 5
3-67
Elec Log

MISSISSIPPI
BOARD OF WATER COMMISSIONERS
416 North State Street
Jackson, Mississippi 39201

WATER WELL DRILLERS LOG

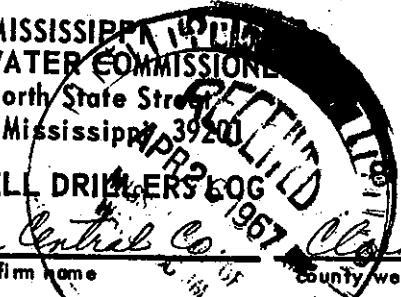

3-30 1967 date well completed
Layne Central Co. firm name
Clarke county well located

LANDOWNER:	description of formations encountered	from	to
Southern Natural Gas Company	Top Soil	2	2
Enterprise, Miss. (mailing address)	Sandy Clay	2	20
	Sand (fine)	20	63
	Clay	63	98
WELL LOCATION: sec. 35 T. 4 N. R. 14 E	Lime Rock (Hard)	98	114
1 miles SW of Enterprise (distance) (direction) (nearest town)	Clay and rock streaks	114	210
	Sandy Clay	210	256
	Sand	256	276
	Clay and sand streaks	276	300
WELL PURPOSE: Industrial (home, irrigation, municipal, industrial)	Hard Shale	300	311
	Sandy Shale	311	520
WELL COMPLETION DATA:	Rock (Hard)	521	522
(1) diameter (inches) 10"	Sandy Shale	522	535
(2) total depth (feet) 1364'	Rock (Hard)	535	536
(3) static water level (feet) 33' below top of ground. flow	Shale	536	550
(4) casing 10" (material) 1315' (depth)	Rock (Hard)	550	552
10" (size) If telescope see back.	Sandy Shale	552	581
(5) screen 40' (length) 3" (size) 3" (material)	Rock (Hard)	581	584
	Shale and sand streaks	584	676
	Rock (Hard)	676	681
	Shale and sand streaks	681	718
	Sandy Shale	718	862
	Hard Shale	862	872
	Sandy Shale	872	1007
	Hard Rock	1007	1010
(6) pump 30 (HP)	Shale and sand streaks	1010	1055
	Hard Shale	1055	1079
	Rock	1079	1083
	Shale and sand streaks	1083	1110
	Hard Shale sand streak	1110	1185
(7) electric log Yes (yes or no)	Sand and shale streaks	1185	1204
Schlumberger (organization running log)	Shale and sand streaks	1204	1260
	Sand	1260	1299
	Clay	1299	1309
(8) how well bottom plugged	Sand	1309	1327
	Sand	1327	1357
DRILLERS REMARKS:	Sand	1357	1375
Pump not installed yet	Sand Rock	1375	1376
No Capacity test made yet	Sand	1376	1380
	Shale	1380	1382