


CLARKE MISSISSIPPI BOARD OF WATER COMMISSIONERS

A 9  
9-18-63

WATER WELL DRILLERS LOG

Date: 9-18, 1963, Driller: Mr. Donald & Will County, Clarke  
(Name)

(1) Owner of Land: <u>George Cotton</u> (Name)	Description & Color of Materials Sand, Clay, Red Clay, Shell, etc.	Thick- ness Feet	Depth Feet
<u>Enterprise, Miss</u> (Address)	Clay	0	10
(2) Location: <u>1/4, 1/4, Sec. 28 T. R.</u>	sd. & sdy. clay	10	30
<u>2 miles west</u> of <u>Enterprise</u> (distance) (direction) (Nearest Town)	sd.	30	115
(3) Topography: <u>Hilly</u> (Hilly) (Flat) (Level)	shale	115	120
(4) Purpose of Well: <u>Domestic</u> (Domestic Irrigation Municipal, Industrial, Other)	sd. shale	120	120
Information upon completion of well:	shale	120	133
(1) Diameter: <u>3 1/2</u> inches.	limey shale	133	140
(2) Total Depth: <u>330</u> feet.	shale	140	150
(3) Water Level: <u>70</u> feet below top of ground.	limey shale & lime	150	160
(4) Cased to: <u>324</u> , Size <u>4 x 2</u>	hard lime	160	170
(5) Screen: Size <u>2"</u> , Length <u>6'</u>	sd.	170	172
(6) Were any formations sealed against pollution? _____ yes, _____ no.	shale	172	180
If YES depth of formation _____	fine sand	180	190
Why _____	shale w/ lime st.	190	225
Drillers Remarks: _____	sd.	225	227
_____	hard lime	227	228
_____	sd.	228	230
_____	shale w/ lime st.	230	250
_____	limey sand	250	252
_____	shale w/ lime st.	252	300
_____	sd.	300	302
_____	Red shale	302	320
_____	Coarse sand	320	335
_____			
_____			
_____			

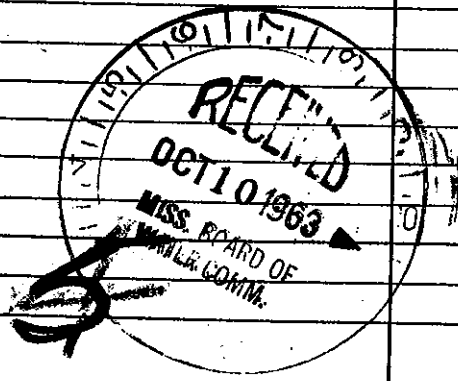

Well No. 110

(Use Back Side)

Mail this copy to Board of Water Commissioners 429 Miss. St. Jackson, Miss