

P

Clarke
3 A15
6-67

MISSISSIPPI
BOARD OF WATER COMMISSIONERS
416 North State Street
Jackson, Mississippi 39201

WATER WELL DRILLERS LOG

JUNE 19 67 PEEPLES DRILLING CO CLARKE
date well completed firm name county well located

LANDOWNER: JIM DOWNS

ENTERPRISE MISS

(mailing address)

WELL LOCATION:


sec. 23 T. 40 N. R. 14 E
TOWN OF ENTERPRISE
miles (distance) direction of (nearest town)

WELL PURPOSE: HOME
(home, irrigation, municipal, industrial)

WELL COMPLETION DATA:

- (1) diameter (inches) 4
- (2) total depth (feet) 231
- (3) static water level (feet) 14 below top of ground.
- (4) casing IRON 45 (material) (depth)
4" (size) If telescope see back.
- (5) screen NONE (length) (depth to top)
(size) (material)
- (6) pump 1/2 (HP) 10 (yield gpm)
ELECT (type power)
- (7) electric log NO (yes or no)
(organization running log)
- (8) how well bottom plugged OPEN

description of formations encountered	from to	
YELLOW SANDY CLAY	0	18
WHITE SAND	18	43
ROCK & BLUE MARL	43	190
WHITE SAND & SHALE STREAKS	190	231

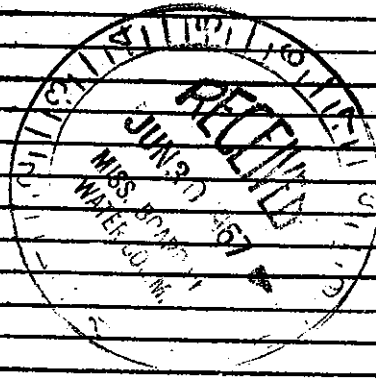

DRILLERS REMARKS: