

P

MISSISSIPPI
 BOARD OF WATER COMMISSIONERS
 416 North State Street
 Jackson, Mississippi 39201

WATER WELL DRILLERS LOG

Clarke
 3 A17
 1-67

JAN 1967 PEEPLES DRILL CO. CLARKE
 date well completed firm name county well located

LANDOWNER: DR. J.C. GRAMM	description of formations encountered	from	to
(mailing address)			
ENTERPRISE, Miss	Yellow Sandy clay	0	15
	Yellow Sand	15	21
	Green Sand & Sand		
	Rock	21	53
	Blue mail & Rock	53	90
	White sand	90	105
	Rock		

WELL LOCATION:
 sec. 24 T. 4 N. R. 14 E
 TOWN OF Enterprise
 miles of (nearest town)

WELL PURPOSE: HOME
 (home, irrigation, municipal, industrial)

WELL COMPLETION DATA:

(1) diameter (inches) 4

(2) total depth (feet) 105

(3) static water level (feet) 13 below top of ground.


(4) casing BLK IRON 6.3 (material) (depth) 4' if telescope see back. (size)

(5) screen NONE (length) (depth to top) (size) (material)

(6) pump 1/3 6 GPM (HP) (yield gpm)
 ELECT. (type power)

(7) electric log NO (yes or no)
 (organization running log)

(8) how well bottom plugged OPEN

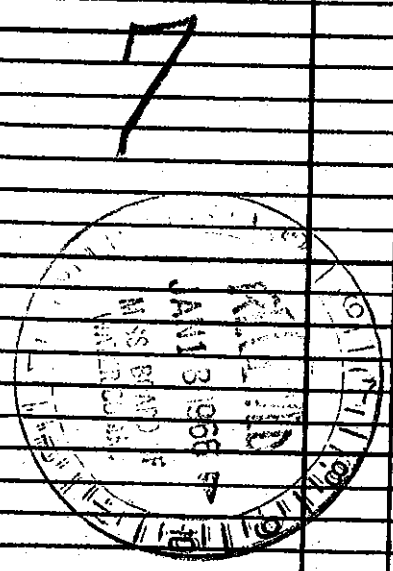

DRILLERS REMARKS: