

LINCOLN
 AT A19
 2-1-65

MISSISSIPPI BOARD OF WATER COMMISSIONERS

WATER WELL DRILLERS LOG

Date: Feb 1, 1965, Driller: Bob Williamson County: Clarke
 (Name)

(1) Owner of Land:	Description & Color of Materials Sand, Clay, Red Clay, Shell, etc.	Thick- ness Feet	Depth Feet
<u>J. L. Floyd</u> (Name)	<u>top soil</u>	<u>2</u>	<u>1-2</u>
Enterprise, Miss. <u>Enterprise, Miss.</u> (Address)	<u>Red clay</u>	<u>8</u>	<u>2-10</u>
(2) Location: <u>1/4</u> , <u>1/4</u> , Sec. <u>4T 4R 14</u>	<u>Red sand</u>	<u>70</u>	<u>10-8</u>
<u>2</u> miles <u>N.W.</u> of <u>Enterprise</u> (distance) (direction) (Nearest Town)	<u>White sand</u>	<u>17</u>	<u>80-97</u>
(3) Topography: <u>hilly</u> (Hilly) (Flat) (Level)			
(4) Purpose of Well: <u>domestic</u> (Domestic Irrigation Municipal, Industrial, Other)			



Information upon completion of well:

- (1) Diameter 2 inches.
- (2) Total Depth 97 feet.
- (3) Water Level 76 feet below top of ground.
- (4) Cased to 90, Size 2"
- (5) Screen: Size 2", Length 5 feet.
- (6) Were any formations sealed against pollution?
 yes, no.

If YES depth of formation _____

Why _____

Drillers Remarks _____

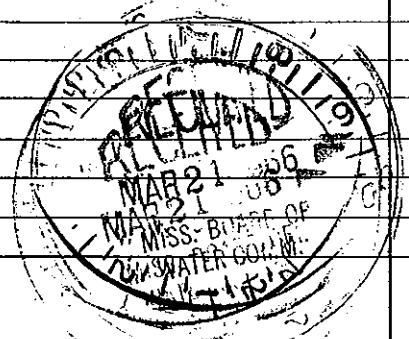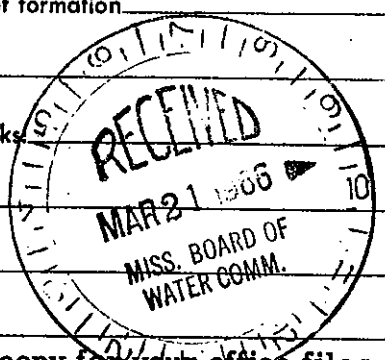

Retain this copy for your office files.

Well No. _____