

Clarke  
3 A 20  
7-66

MISSISSIPPI BOARD OF WATER COMMISSIONERS

P

WATER WELL DRILLERS LOG

Date: July, 1966, Driller: People Drilling Co. County Clarke  
(Name)

(1) Owner of Land:	Description & Color of Materials Sand, Clay, Red Clay, Shell, etc.	Thick- ness Feet	Depth Feet
<u>Henry Williams</u> (Name) <u>Enterprise, Miss.</u> (Address)	<u>Yellow Sandy clay</u>	<u>18</u>	<u>18</u>
	<u>White Sand</u>	<u>10</u>	<u>28</u>
(2) Location: <u>SE 1/4, SE 1/4, Sec. 23, T. 14 N. R. 5 E.</u> <u>Journal of Enterprise</u> miles (distance), of (direction), of (Nearest Town)	<u>Blue marl</u>	<u>17</u>	<u>45</u>
	<u>Blue marl rock</u>	<u>39</u>	<u>84</u>
	<u>Green sand</u>	<u>8</u>	<u>92</u>
(3) Topography: <u>Flat</u> (Hilly) (Flat) (Level)	<u>Blue rock + blue</u>		
	<u>marl streaks</u>	<u>118</u>	<u>210</u>
(4) Purpose of Well: <u>Home</u> (Domestic Irrigation Municipal, Industrial, Other)	<u>Gray sandy streak +</u>		
	<u>white sand streak</u>	<u>15</u>	<u>225</u>
	<u>white sand + small</u>		
	<u>shale streaks</u>	<u>15</u>	<u>240</u>


Information upon completion of well:

- (1) Diameter 4 inches.
- (2) Total Depth 240 feet.
- (3) Water Level 12 feet below top of ground.
- (4) Cased to 42', Size 4"
- (5) Screen: Size NONE, Length \_\_\_\_\_
- (6) Were any formations sealed against pollution?  
 yes,  no.

If YES depth of formation \_\_\_\_\_

Why \_\_\_\_\_

Drillers Remarks: \_\_\_\_\_

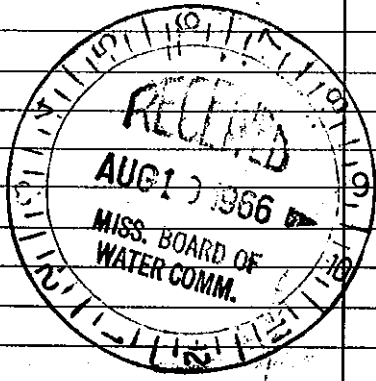

Well No.

(Use Back Side)

Mail this copy to Board of Water Commissioners 429 Miss. St. Jackson, Miss.