

Clarke
3 A 21
7-66

MISSISSIPPI BOARD OF WATER COMMISSIONERS

P

WATER WELL DRILLERS LOG

Date: July, 1966, Driller: Peoples Drilling Co County Clarke
(Name)

(1) Owner of Land: <u>Barnie King</u> (Name)	Description & Color of Materials Sand, Clay, Red Clay, Shell, etc.	Thick- ness Feet	Depth Feet
<u>Rt. 2 Enterprise, Miss.</u> (Address)	<u>Red sandy clay</u>	<u>21</u>	<u>21</u>
(2) Location: <u>NW 1/4, NW 1/4, Sec. 16, T4R E,</u> <u>5 miles E</u> of <u>Enterprise</u> (distance) (direction) (Nearest Town)	<u>Yellow sand & clay streaks</u>	<u>49</u>	<u>70</u>
(3) Topography: <u>Hilly</u> (Hilly) (Flat) (Level)	<u>Red sand</u>	<u>20</u>	<u>90</u>
(4) Purpose of Well: <u>Home</u> (Domestic Irrigation Municipal, Industrial, Other)	<u>White sand</u>	<u>25</u>	<u>115</u>

Information upon completion of well:

(1) Diameter 2 inches.

(2) Total Depth 115 feet.

(3) Water Level 63 feet below top of ground.

(4) Cased to 105', Size 2"


(5) Screen: Size 2", Length 6'

(6) Were any formations sealed against pollution?
 yes, no.

If YES depth of formation _____

Why _____

Drillers Remarks: _____

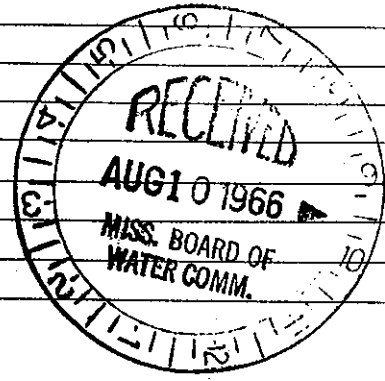

Well No.

(Use Back Side)

Mail this copy to Board of Water Commissioners 429 Miss. St. Jackson, Miss.