

BOARD OF WATER COMMISSIONERS

P

CLARKE

WATER WELL DRILLERS LOG

Date: May 5, 1966, Driller: Peoples Drilling Co County Clarke
 (Name)

(1) Owner of Land: <u>John Drellman</u> (Name)	Description & Color of Materials Sand, Clay, Red Clay, Shell, etc.	Thick- ness Feet	Depth Feet
<u>Enterprise, Miss.</u> (Address)	<u>Yellow sandy clay</u>	<u>12</u>	<u>12</u>
(2) Location: <u>Town of Enterprise</u> <u>1/4, 1/8, Sec. 24 4N 19E</u>	<u>Blue clay</u>	<u>8</u>	<u>20</u>
_____ miles _____ of _____ (distance) (direction) (Nearest Town)	<u>Red shale</u>	<u>4</u>	<u>24</u>
(3) Topography: <u>Flat</u> (Hilly) (Flat) (Level)	<u>White sand</u>		
(4) Purpose of Well: <u>Home</u> (Domestic Irrigation Municipal, Industrial, Other)	<u>Boulders</u>	<u>16</u>	<u>42</u>
	<u>Sand Rock</u>	<u>12</u>	<u>54</u>
	<u>Green sand</u>	<u>14</u>	<u>70</u>
	<u>Blue marl & rock</u>	<u>119</u>	<u>189</u>
	<u>Gray sandy shale</u>	<u>17</u>	<u>206</u>
	<u>White sand</u>	<u>29</u>	<u>235</u>

Information upon completion of well:

(1) Diameter 4 inches.

(2) Total Depth 235 feet.

(3) Water Level 15 feet below top of ground.

(4) Cased to 84', Size 4"


(5) Screen: Size NONE, Length _____

(6) Were any formations sealed against pollution?
 _____ yes, _____ no.

If YES depth of formation _____

Why _____

Drillers Remarks: _____

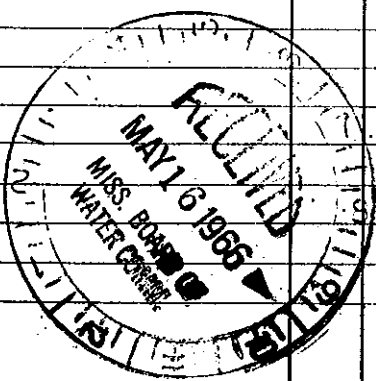

Well No. _____

(Use Back Side)

Mail this copy to Board of Water Commissioners 429 Miss. St. Jackson, Miss