

CLARKE

MISSISSIPPI BOARD OF WATER COMMISSIONERS

P

5A26

3-66

WATER WELL DRILLERS LOG

Date: March, 1966, Driller: Peoples Drilling Co County Clarke
(Name)


(1) Owner of Land: Cooper
(Name)
Enterprise, Miss.
(Address)
(2) Location: Town of Enterprise
1/4, 1/4, Sec. 24 T. 41 N. R. 14 E
_____ miles _____ of _____
(distance) (direction) (Nearest Town)
(3) Topography: Flat
(Hilly) (Flat) (Level)
(4) Purpose of Well: Home
(Domestic Irrigation
Municipal, Industrial, Other)

Description & Color of Materials Sand, Clay, Red Clay, Shell, etc.	Thick- ness Feet	Depth Feet
<u>Yellow sandy clay</u>	<u>10</u>	<u>10</u>
<u>Green sand shale</u>	<u>12</u>	<u>22</u>
<u>Green sand</u>	<u>25</u>	<u>45</u>
<u>Blue marl + rock breaks</u>	<u>123</u>	<u>168</u>
<u>Gray sandy shale</u>	<u>10</u>	<u>178</u>
<u>White sand + Brown shale streaks</u>	<u>22</u>	<u>200</u>

Information upon completion of well:

(1) Diameter 4 inches.
(2) Total Depth 200 feet.
(3) Water Level 12 feet below top of ground.
(4) Cased to 63', Size 4"
(5) Screen: Size None, Length _____
(6) Were any formations sealed against pollution?
_____ yes, _____ no.

If YES depth of formation _____
Why _____
Drillers Remarks: _____

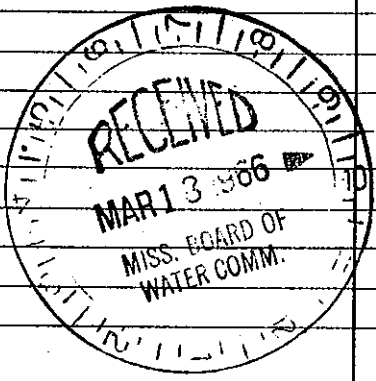

Well No.

(Use Back Side)

Mail this copy to Board of Water Commissioners 429 Miss. St. Jackson, Miss.