

CLARKE
5 A 27
7-62

MISSISSIPPI BOARD OF WATER COMMISSIONERS

WATER WELL DRILLERS LOG

Date: July 19 1962, Driller: Peoples & Kullberg County Clarke (Name)


(1) Owner of Land: John Burns (Name)
Enterprise, Miss. (Address)
23 (Address)
(2) Location: 1/4, 1/4, Sec. 17 T4 R14, (Distance) 2 miles west (direction), of Enterprise (Nearest Town)
(3) Topography: Hilly (Hilly) (Flat) (Level)
(4) Purpose of Well: Domestic (Domestic Irrigation Municipal, Industrial, Other)

Description & Color of Materials Sand, Clay, Red Clay, Shell, etc.	Thick- ness Feet	Depth Feet
Red sandy clay	18	18
yellow sand	24	42
White sand + clay shale	7	49
White + yellow sand	61	110

Information upon completion of well:

(1) Diameter 2 inches.
 (2) Total Depth 110 feet.
 (3) Water Level 50 feet below top of ground.
 (4) Cased to 105, Size 2"
 (5) Screen: Size 2", Length 6'
 (6) Were any formations sealed against pollution?
 yes, no.

If YES depth of formation _____
 Why _____
 Drillers Remarks: Blind hole from 94 feet.

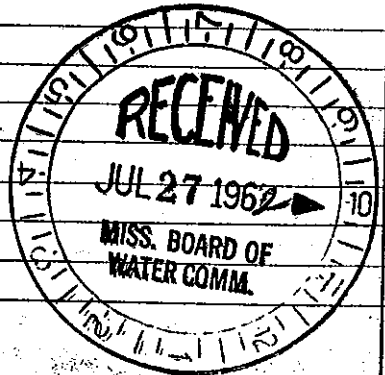

Well No.

Mail this copy to Board of Water Commissioners 429 Miss. St. Jackson, Miss

(Use Back Side)