

CLARKE MISSISSIPPI BOARD OF WATER COMMISSIONERS

3, ~~429~~ A29
7-62

P

WATER WELL DRILLERS LOG

Date: July, 1962, Driller: Reeplant Rutledge County Clarke
(Name)

(1) Owner of Land: <u>Anna Hopkins</u> (Name)	Description & Color of Materials Sand, Clay, Red Clay, Shell, etc.	Thick- ness Feet	Depth Feet
<u>Enterprise, Miss.</u> (Address)	<u>Top to yellow sand</u>	<u>28</u>	<u>28</u>
(2) Location: <u>NE 1/4, SW 1/4, Sec 23 T4R14</u>	<u>Blue shale</u>	<u>25</u>	<u>53</u>
<u>Town of Enterprise</u>	<u>Green rock + chert</u>	<u>17</u>	<u>70</u>
<u>miles</u> (distance), <u>of</u> (direction), <u>of</u> (Nearest Town)	<u>Green chert + black sand</u>	<u>20</u>	<u>90</u>
(3) Topography: <u>Flat</u> (Hilly) (Flat) (Level)	<u>Green rock + green</u>		
(4) Purpose of Well: <u>Domestic</u> (Domestic Irrigation Municipal, Industrial, Other)	<u>shale streaks</u>	<u>109</u>	<u>199</u>
	<u>gray sandy shale</u>	<u>17</u>	<u>216</u>
	<u>white sand</u>	<u>24</u>	<u>240</u>

Information upon completion of well:


- (1) Diameter 4 inches.
- (2) Total Depth 240 feet.
- (3) Water Level 14 feet below top of ground.
- (4) Cased to 42', Size 4"
- (5) Screen: Size NONE, Length _____
- (6) Were any formations sealed against pollution?
 yes, _____ no.

If YES depth of formation 28

Why surface water

Drillers Remarks: _____

3

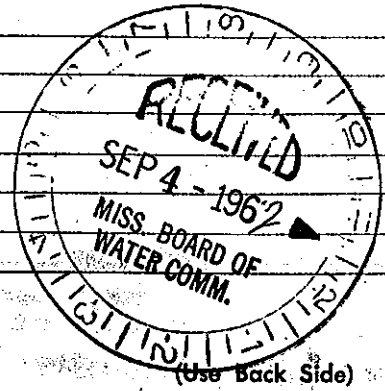

Well No.

Mail this copy to Board of Water Commissioners 429 Miss. St. Jackson, Miss