

CLARKE

MISSISSIPPI BOARD OF WATER COMMISSIONERS

4 A30

P

3-62

WATER WELL DRILLERS LOG


Date: March, 1962, Driller: Reaper + Rutledge County Clarke

(Name)

(1) Owner of Land: <u>Floyd Little</u> <small>(Name)</small>	Description & Color of Materials Sand, Clay, Red Clay, Shell, etc.	Thick- ness Feet	Depth Feet
<u>Enterprise, Miss.</u> <small>(Address)</small>	<u>Top soil to yellow</u>		
(2) Location: <u>Town of Enterprise</u> <small>1/4, 1/4, Sec. 24 4N 14E</small>	<u>sand</u>	19	19
<u>Center of Enterprise</u> <small>miles, of, (distance) (direction) (Nearest Town)</small>	<u>White sand</u>	15	34
(3) Topography: <u>Flat</u> <small>(Hilly) (Flat) (Level)</small>	<u>Green Rock</u>	24	58
(4) Purpose of Well: <u>Domestic</u> <small>(Domestic Irrigation Municipal, Industrial, Other)</small>	<u>Blue marl</u>	12	70
	<u>Blue marl &amp; Rock streak</u>	24	94
	<u>White sand + Rock</u>		
	<u>streak</u>	11	105

Information upon completion of well:

- (1) Diameter 3 inches.
- (2) Total Depth 105 feet.
- (3) Water Level 19' feet below top of ground.
- (4) Cased to 63', Size 3"
- (5) Screen: Size NONE, Length \_\_\_\_\_
- (6) Were any formations sealed against pollution?  
 yes,  no.
- If YES depth of formation 34'
- Why Surface strata
- Drillers Remarks: \_\_\_\_\_

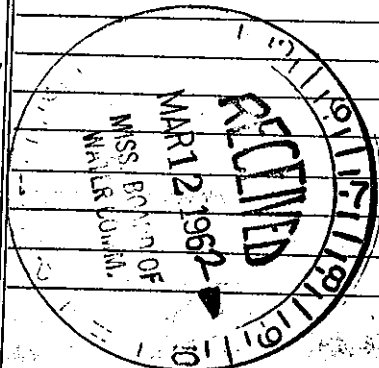

(Use Back Side)

Well No

Mail this copy to Board of Water Commissioners 429 Miss. St. Jackson, Miss