

WATER COMMISSIONERS

P

CLARKE

4 A 31
9-21-61

WATER WELL DRILLERS LOG A-301

Date: 9-21, 1961, Driller: Pegsler & Rutledge County Clarke

(Name)

(1) Owner of Land:	Description & Color of Materials Sand, Clay, Red Clay, Shell, etc.	Thick- ness Feet	Depth Feet
J.O. Moore (Name)	Yellow Sandy Clay	18	18
Enterprise, Miss. (Address)	Green Sand Rock	7	25
(2) Location: Town of Enterprise, Sec. 24 T. 14 N. R. 14 E	Rock & Chert Strata	27	52
1/4, 1/4, 1/4, Chickasawhay	Green Sand	6	58
1/2 miles West of River (distance) (direction) (Nearest Town)	Shale & Rock Strata	28	86
(3) Topography: flat (Hilly) (Flat) (Level)	White sand	9	95
(4) Purpose of Well: Domestic (Domestic Irrigation Municipal, Industrial, Other)			


Information upon completion of well:

- (1) Diameter 4" inches.
- (2) Total Depth 95 feet.
- (3) Water Level 15 feet below top of ground.
- (4) Cased to 63', Size 4"
- (5) Screen: Size None, Length _____
- (6) Were any formations sealed against pollution?
X yes, _____ no.

If YES depth of formation 18'

Why River Bottom Sand

Drillers Remarks:

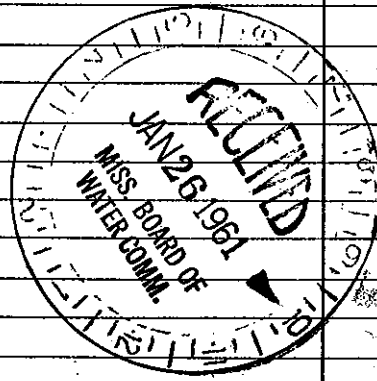

(Use Back Side)

Well No.

Mail this copy to Board of Water Commissioners 429 Miss. St. Jackson, Miss