

CLARKE
4 A 32
11-64

MISSISSIPPI BOARD OF WATER COMMISSIONERS

WATER WELL DRILLERS LOG

Date: Nov., 1964, Driller: Peeples Drilling Co County Clarke
(Name)

(1) Owner of Land: <u>James Robert Kemp</u> (Name)	Description & Color of Materials Sand, Clay, Red Clay, Shell, etc.	Thick- ness Feet	Depth Feet
<u>Enterprise, Miss</u> (Address)	<u>Yellow Sandy Clay</u>	<u>15</u>	<u>15</u>
(2) Location: <u>1/4</u> , <u>1/4</u> , Sec <u>24</u> <u>4N14E</u> T. R.	<u>Yellow Sand</u>	<u>16</u>	<u>31</u>
<u>1/8</u> miles <u>W</u> , of <u>Enterprise</u> (distance) (direction) (Nearest Town)	<u>Green Sand Rock</u>	<u>21</u>	<u>52</u>
(3) Topography: <u>Flat</u> (Hilly) (Flat) (Level)	<u>Blue Marl + Rock shale</u>	<u>11</u>	<u>63</u>
(4) Purpose of Well: <u>Home</u> (Domestic Irrigation Municipal, Industrial, Other)	<u>sand streak to blue marl</u>		
	<u>+ rock</u>	<u>17</u>	<u>80</u>
	<u>blue marl + rock</u>	<u>109</u>	<u>189</u>
	<u>gray sandy shale</u>	<u>11</u>	<u>200</u>
	<u>white sand</u>	<u>29</u>	<u>229</u>


Information upon completion of well:

- (1) Diameter 4 inches.
- (2) Total Depth 229 feet.
- (3) Water Level 14 feet below top of ground.
- (4) Cased to 84', Size 4"
- (5) Screen: Size NONE, Length _____.
- (6) Were any formations sealed against pollution?
_____ yes, _____ no.

If YES depth of formation _____

Why _____

Drillers Remarks: _____

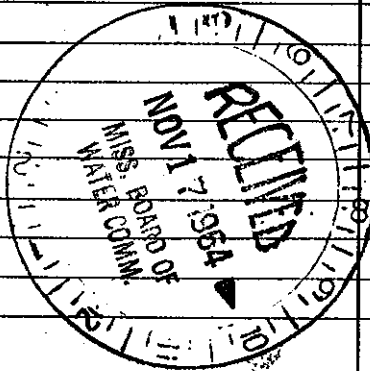

Well No.

(Use Back Side)

Mail this copy to Board of Water Commissioners 429 Miss. St. Jackson, Miss.