


5  
 CLARK  
 A 33  
 12-63

WATER WELL DRILLERS LOG

P

Date: Dec., 19 63, Driller: Peoples Drilling Co. County Clarke  
 (Name)

	Description & Color of Materials Sand, Clay, Red Clay, Shell, etc.	Thick- ness Feet	Depth Feet
(1) Owner of Land: <u>Amos Hopkins</u> (Name) <u>Enterprise, Miss.</u> (Address)	<u>0-6 red clay</u>		
(2) Location: $\frac{1}{4}$ , $\frac{1}{4}$ , Sec <u>22</u> <sup>4N 14E</sup> T R <u>1/2</u> miles <u>West</u> of <u>Enterprise</u> (distance) (direction) (Nearest Town)	<u>6-20 sand</u> <u>20-220 Green chert,</u> <u>with grey shale</u> <u>220-240 Grey sand</u>		
(3) Topography: <u>Flat</u> (Hilly) (Flat) (Level)			
(4) Purpose of Well: <u>Domestic</u> (Domestic Irrigation Municipal, Industrial, Other)			
Information upon completion of well:			
(1) Diameter <u>4"</u> inches.			
(2) Total Depth <u>240</u> feet.			
(3) Water Level <u>6'</u> feet below top of ground.			
(4) Cased to <u>42'</u> , Size <u>4"</u>			
(5) Screen: Size <u>—</u> , Length <u>—</u>			
(6) Were any formations sealed against pollution?			
<input checked="" type="checkbox"/> yes, <input type="checkbox"/> no.			
If YES depth of formation <u>20'</u>			
Why <u>Possible pollution</u>			
Drillers Remarks:			

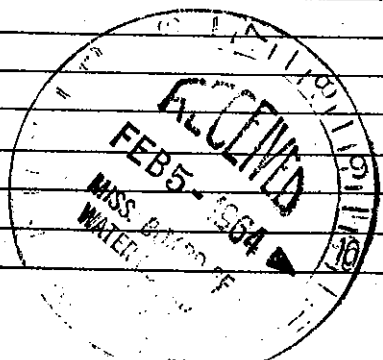

(Use Back Side)

Well No.

Mail this copy to Board of Water Commissioners 429 Miss. St. Jackson, Miss.