


5 CLARKE
A35
5-63

WATER WELL DRILLERS LOG

P

Date: May, 1963, Driller: St. Angelo Drilling Co County Clarke
(Name)

(1) Owner of Land:	Description & Color of Materials Sand, Clay, Red Clay, Shell, etc.	Thick- ness Feet	Depth Feet
(Name) <u>Louise Price</u>	<u>Yellow sandy clay</u>	<u>12</u>	<u>12</u>
(Address) <u>Enterprise Miss</u>	<u>White sand</u>	<u>19</u>	<u>31</u>
(2) Location: $\frac{1}{4}$, $\frac{1}{4}$, Sec. <u>22</u> ^{4N14E} T. R.	White sand <u>Dark shale</u>	<u>29</u>	<u>60</u>
$\frac{1}{2}$ miles <u>W</u> of <u>Enterprise</u>	<u>Rock</u>	<u>13</u>	<u>73</u>
(distance) (direction) (Nearest Town)	<u>Green sand</u>	<u>22</u>	<u>95</u>
(3) Topography: <u>Flat</u>	<u>Rock + Green shale</u>	<u>104</u>	<u>199</u>
(Hilly) (Flat) (Level)	<u>Gray sandy shale</u>	<u>14</u>	<u>215</u>
(4) Purpose of Well: <u>Domestic</u>	<u>White sand</u>	<u>14</u>	<u>231</u>
(Domestic Irrigation Municipal, Industrial, Other)	<u>Gray shale + sandstone</u>	<u>21</u>	<u>252</u>
Information upon completion of well:			
(1) Diameter <u>4</u> inches.			
(2) Total Depth <u>252</u> feet.			
(3) Water Level <u>15</u> feet below top of ground.			
(4) Cased to <u>105'</u> , Size <u>4"</u>			
(5) Screen: Size <u>NONE</u> , Length _____			
(6) Were any formations sealed against pollution?			
_____ yes, _____ no.			
If YES depth of formation _____			
Why _____			
Drillers Remarks: _____			

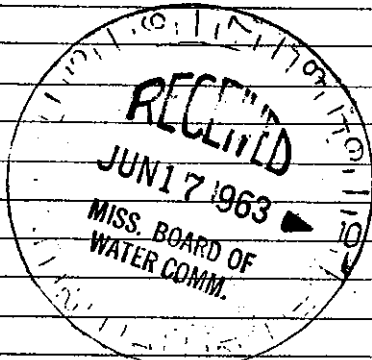

(Use Back Side)

Well No.

Mail this copy to Board of Water Commissioners 429 Miss. St. Jackson, Miss